

JACKSON
H 2003
5/76

MISSISSIPPI
BOARD OF WATER COMMISSIONERS
416 North State Street
Jackson, Mississippi 39201

132

WATER WELL DRILLERS LOG

date well completed 19 76 firm name Franklin Well Co county well located Jackson

LANDOWNER: Robert

description of formations encountered

from to

Robert Pt. 5

red clay sand 0' 8'

Princeton Ave
(mailing address)

white sandstone 8' 20'

WELL LOCATION:

pinkish sand clay 25'
w/ sand interbed 4'

sec. 15 T. 5 N. R. 5 E. W
2 miles (distance) W of W (direction) (nearest town)

fine to med white 40'
sand 3'

WELL PURPOSE: Home
(home, irrigation, municipal, industrial)

WELL COMPLETION DATA:


- diameter (inches) 2"
- total depth (feet) 6'
- static water level (feet) 9' below above top of ground.
- casing 1 1/2" (material) 5' (depth)
1 1/2" if telescope see back.
(size)
- screen 5' (length) 5' (depth to top)
7" (size) 1 1/2" (material)
- pump 1 (HP) 10 (yield gpm)
re (type power)
- electric log no (yes or no)
(organization running log)
- how well bottom plugged Fig. 4.

DRILLERS REMARKS:

MAY 15 1976
MISSISSIPPI BOARD OF WATER COMMISSIONERS

If well telescopes please sketch and show depths.

GROUND LEVEL

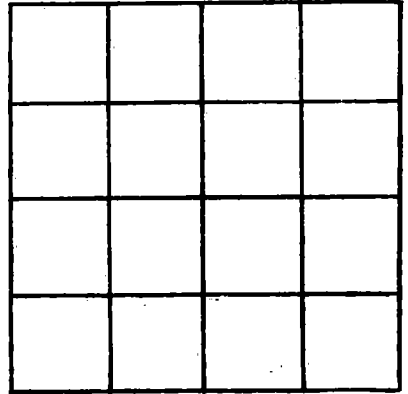

SECTION _____

Please indicate well location X.

ADDITIONAL INFORMATION

If more than one screen, show locations of each on sketch.