

JACKSON
H 2004
1-28-77

MISSISSIPPI
BOARD OF WATER COMMISSIONERS
416 North State Street
Jackson, Mississippi 39201

WATER WELL DRILLERS LOG
COASTAL DRILLING & SERVICE CO.

1/28/77
date well completed

ROUTE 1 BOX 618
DIXON, MISS. 39532

Jackson
county well located

LANDOWNER: Bill Lane

description of formations encountered	from	to
top soil	1	2
Red Clay	2	45
white sand	45	28
Sugar sand	28	60
Wood sand	60	75
Soft blue clay	75	130
fine water sand	130	150
Soft blue clay	150	170
hard blue clay	170	250
Rock	250	255
fine water sand	255	270
fine water sand	270	300
hard blue clay	300	530
Wood	300	550
hard blue clay	550	750
Coarse water sand	750	825

PO: Box 16
Husley Miss
(mailing address)

WELL LOCATION:
sec 10 T 5 N R 5 E
Big Spring
(distance) (direction) (nearest town)

WELL PURPOSE: home
(home, irrigation, municipal, industrial)

WELL COMPLETION DATA:

- (1) diameter (inches) 2"
- (2) total depth (feet) 825'
- (3) static water level (feet) one below top of ground Flow above
- (4) casing PVC, 810
(material) (depth)
(size) If telescope see back.
- (5) screen 15', 810'
(length) (depth to top)
2", PVC
(size) (material)
- (6) pump 1/2, 20
(HP) (yield gpm)
ole
(type power)
- (7) electric log no
(yes or no)
(organization running log)

(8) how well bottom plugged 2" gravel


DRILLERS REMARKS:
Well went 300ft
only 1st well and
had to go back to 825ft

RECEIVED
FEB 23 1977

MISS. BD. OF WATER COMM

If well telescopes please sketch and show depths.

GROUND LEVEL

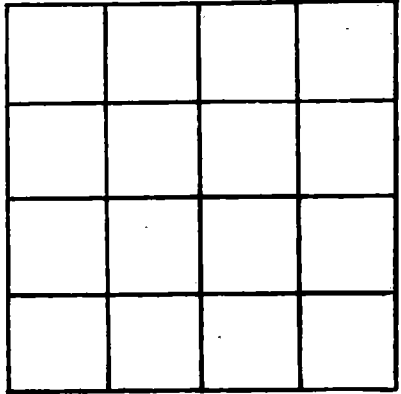

SECTION _____

Please indicate well location X.

ADDITIONAL INFORMATION

If more than one screen, show locations of each on sketch.