

JACKSON
 H 2005
 4-26-77

MISSISSIPPI
 BOARD OF WATER COMMISSIONERS
 416 North State Street
 Jackson, Mississippi 39201

WATER WELL DRILLERS LOG

JACKSON
 Big Point

April 26, 1977 date well completed
 Polville Water Supply firm name
 Big Point county well located


LANDOWNER:	description of formations encountered	from	to
Billy Harris Big Point	sand & gravel	0	22
(mailing address)	sand	22	44
WELL LOCATION:	sand	44	66
sec 27 T 5 N R 5 E	sand	66	88
1/2 miles N of MP	sand	88	110
(distance) (direction) (nearest town)	sand	110	120
WELL PURPOSE: house	Clay	120	132
(home, irrigation, municipal, industrial)	Clay	132	154
WELL COMPLETION DATA:	Clay	154	176
(1) diameter (inches) 2 in	Clay	176	198
(2) total depth (feet) 405 ft	Clay	198	220
(3) static water level (feet) 2 below top of ground	Clay	220	242
(4) casing PVC, 400 ft (material) (depth)	Clay	242	264
2 in If telescope see back. (size)	sand (fine)	264	270
(5) screen 5 ft, 405 ft (length) (depth to top)	sand (fine)	270	286
2 in, PVC (size) (material)	clay (shk)	286	308
(6) pump (HP) (yield gpm)	clay (shk)	308	330
elec (type power)	Clay	330	340
(7) electric log no (yes or no)	sand	340	352
no (organization running log)	sand	352	374
(8) how well bottom plugged BP valve	sand	374	405
DRILLERS REMARKS: pump furnished by owner			

RECEIVED
 JUN 9 1977

MISS. BD. OF WATER COMMISSIONERS

If well telescopes please sketch and show depths.

GROUND LEVEL

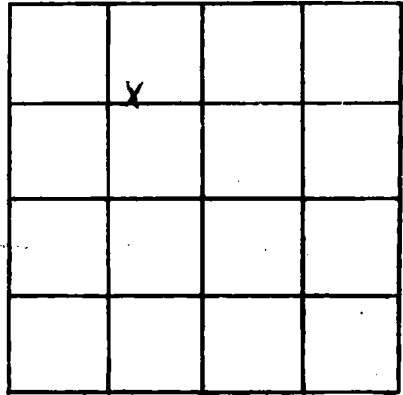

SECTION 27

Please indicate well location X.

ADDITIONAL INFORMATION

If more than one screen, show locations of each on sketch.