

② Jackson
 H 7008
 5/23/77

MISSISSIPPI
 BOARD OF WATER COMMISSIONERS
 416 North State Street
 Jackson, Mississippi 39201

WATER WELL DRILLERS LOG

5-23-77 date well completed
 13 R Coach Water Well Sew. firm name
 Jackson county well located

LANDOWNER: Jackson Co
 Municipal Self Course
 Hwy 613 - Big Point,
 Miss.
 (mailing address)

| description of formations encountered | from | to |
|---------------------------------------|------|----|
| Top Soil | 0 | 1 |
| Sand (m) | 1 | 7 |
| Red Clay | 7 | 12 |
| Sand (mc) | 12 | 84 |

WELL LOCATION:
 sec 16 T 5 S R 5 W
 3 1/2 miles S of Hurley
 (distance) (direction) (nearest town)

WELL PURPOSE: Municipal
 (home, irrigation, municipal, industrial)

WELL COMPLETION DATA:

(1) diameter (inches) 3"

(2) total depth (feet) 84'

(3) static water level (feet) 20' below top of ground

(4) casing PVC 74' (material) (depth)
 2" (size) if telescope see back.

(5) screen 10' 74' (length) (depth to top)
 2" (size) PVC (material)

(6) pump 1 h.p. 15 (HP) (yield gpm)
 Elec. (type power)

(7) electric log No (yes or no)
 (organization running log)

(8) how well bottom plugged
 backwash valve


DRILLERS REMARKS:

RECEIVED
 NOV - 7 1977

MISS. Bd. OF WATER COMM.

If well telescopes please sketch and show depths.

GROUND LEVEL

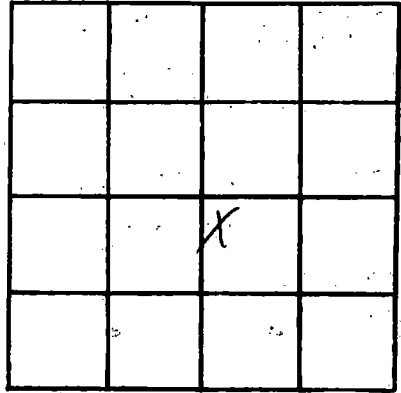

SECTION 16

Please indicate well location X.

ADDITIONAL INFORMATION

If more than one screen, show locations of each on sketch.