

③ Jackson
 H 2009
 5/24/77

MISSISSIPPI
 BOARD OF WATER COMMISSIONERS
 416 North State Street
 13R Jackson, Mississippi 39201

WATER WELL DRILLERS LOG

5-24-77, 19 Cross Water Well Sew. Jackson
 date well completed firm name county well located

LANDOWNER: Jackson Co.
 Municipal Golf Course
 Hwy 613 - Big Pine,
 Miss.
 (mailing address)

description of formations encountered	from	to
Top Soil	0	1
Red Clay	1	5
Or Sand gravel	5	36
Grey Clay	36	51
Sand (mc)	51	78

WELL LOCATION:
 sec 16 T 5 S R 5 W
 3 1/2 miles S of Hurley
 (distance) (direction) (nearest town)

WELL PURPOSE: Municipal
 (home, irrigation, municipal, industrial)

WELL COMPLETION DATA:

(1) diameter (inches) 2" -

(2) total depth (feet) 78'

(3) static water level (feet) 15' below top of ground.

(4) casing PVC, 68' (material) (depth)
 2" (size) if telescope see back.

(5) screen 10' 68' (length) (depth to top)
 2" PVC (size) (material)

(6) pump 1 h.p. 15 (HP) (yield gpm)
 Elec (type power)

(7) electric log No (yes or no)
 (organization running log)

(8) how well bottom plugged
 bad work valve


DRILLERS REMARKS:

RECEIVED
 NOV - 7 1977

MISS. BD. OF WATER COMM.

If well telescopes please sketch and show depths.

GROUND LEVEL

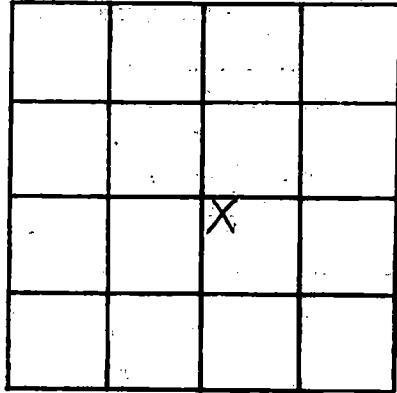

SECTION 16

Please indicate well location X.

ADDITIONAL INFORMATION

Lined area for additional information.

If more than one screen, show locations of each on sketch.