

JACKSON
 H 2010
 6-2-77

MISSISSIPPI
 BOARD OF WATER COMMISSIONERS
 416 North State Street
 Jackson, Mississippi 39201

WATER WELL DRILLERS LOG

June 2 1977 date well completed
 R. Colville Drilling Co. firm name
 Jackson county well located


LANDOWNER:	description of formations encountered	from	to
Lewis Wick Helena, MS (mailing address)	Clay sand Clay sand	0	15 70 120 135
WELL LOCATION: 2 sec. 32 T- ⁵ N R- ⁵ E 10 miles N of M.P. (distance) (direction) (nearest town)			
WELL PURPOSE: home (home, irrigation, municipal, industrial)			
WELL COMPLETION DATA: (1) diameter (inches) 2 (2) total depth (feet) 135 (3) static water level (feet) 27 below above top of ground. (4) casing PVC, 130, (material) (depth) (size) If telescope see back. (5) screen 5', 130, (length) (depth to top) 2", PVC (size) (material) (6) pump 1, 11, (HP) (yield gpm) lhc (type power) (7) electric log no (yes or no) (organization running log) (8) how well bottom plugged B.P. Weber			
DRILLERS REMARKS:			

RECEIVED
 JUN 9 1977

MISS. BD. OF WATER COMMISSIONERS

If well telescopes please sketch and show depths.

GROUND LEVEL

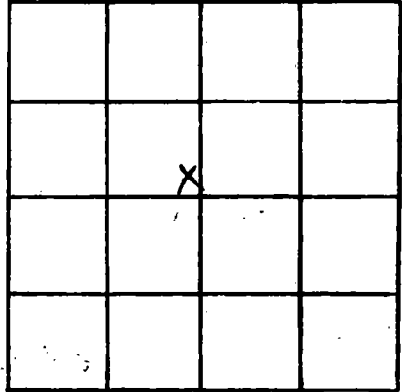

SECTION 32

Please indicate well location X.

ADDITIONAL INFORMATION

If more than one screen, show locations of each on sketch.