

JACKSON  
H 2011  
7-5-77

MISSISSIPPI  
BOARD OF WATER COMMISSIONERS  
416 North State Street  
Jackson, Mississippi 39201

WATER WELL DRILLERS LOG

JULY 5 1977 D & H WELL CO JACKSON  
date well completed firm name county well located

LANDOWNER: W.C. MANNING  
P.O. Box 9 Aimpont Blue  
Hurley Miss 39555  
(mailing address)

description of formations encountered	from	to
SANDY CLAY	0	10
CLAY	10	20
WATER SAND	20	36

WELL LOCATION:  
sec. 2 T 5 N R. 5 E  
2 miles S EAST of Hurley  
(distance) (direction) (nearest town)

WELL PURPOSE: Home  
(home, irrigation, municipal, industrial)

WELL COMPLETION DATA:  
(1) diameter (inches) 2  
(2) total depth (feet) 36  
(3) static water level (feet) 12 below top of ground.  
(4) casing P.V.C. 31 FT  
(material) (depth)  
2" If telescope see back.  
(size)  
(5) screen 5 FT 31 FT  
(length) (depth to top)  
2" P.V.C.  
(size) (material)  
(6) pump 1 12  
(HP) (yield gpm)  
ELEC.  
(type power)  
(7) electric log (yes or no)  
(organization running log)  
(8) how well bottom plugged  
WASH BLUE

DRILLERS REMARKS:


RECEIVED

AUG 29 1977

MISS. BD. OF WATER COMM

If well telescopes please sketch and show depths.

GROUND LEVEL

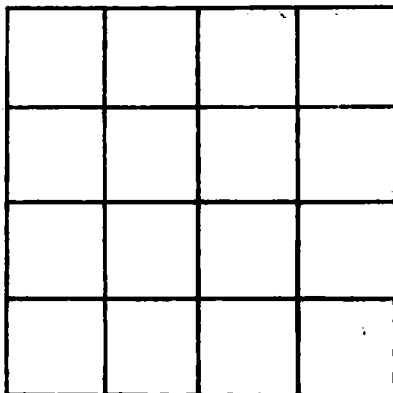

SECTION \_\_\_\_\_

Please indicate well location X.

ADDITIONAL INFORMATION

If more than one screen, show locations of each on sketch.