

MISSISSIPPI
BOARD OF WATER COMMISSIONERS
416 North State Street
Jackson, Mississippi 39201

WATER WELL DRILLERS LOG

JACKSON
H 2012
7/7/77

13R

July 7 1977 Griff Walls Jackson
date well completed firm name county well located

LANDOWNER: Charles L. Linnard

Rt 2

Pascagoula
(mailing address)

WELL LOCATION:

sec 6 T 5 N R 4 E
4 miles east of Hurley
(distance) (direction) (nearest town)

WELL PURPOSE: Home
(home, irrigation, municipal, industrial)

WELL COMPLETION DATA:

- (1) diameter (inches) 2"
- (2) total depth (feet) 55'
- (3) static water level (feet) 38' below top of ground.
- (4) casing PVC, 50' (material) (depth)
If telescope see back.
- (5) screen 5' (length), 50' (depth to top)
2" (size), PVC (material)
- (6) pump 1 (HP), 12 (yield gpm)
elc (type power)
- (7) electric log no (yes or no)
(organization running log)
- (8) how well bottom plugged B. Linnard


description of formations encountered	from	to
red clay	0	18'
sand	18'	30'
yellow & white clay	35'	40'
white sand	40'	55'

DRILLERS REMARKS:

RECEIVED
AUG 12 1977
MISS. BD. OF WATER COMMISSIONERS

If well telescopes please sketch and show depths.

GROUND LEVEL

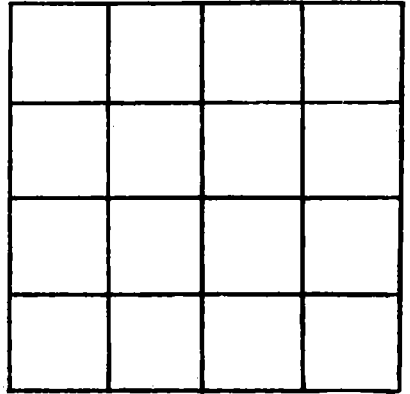

SECTION _____

Please indicate well location X.

ADDITIONAL INFORMATION

If more than one screen,
show locations of each on sketch.