

Jackson  
 H 2013  
 3/21/78

MISSISSIPPI  
 BOARD OF WATER COMMISSIONERS  
 416 North State Street  
 Jackson, Mississippi 39201

WATER WELL DRILLERS LOG

March 21 1978 date well completed  
 Griffin Well Co firm name  
 Jackson county well located

LANDOWNER: Sonny Ray  
 Pt 2  
 Poscogoma Miss.  
 (mailing address)  
 WELL LOCATION:  
 sec 11 T 5 N R 5 E  
 3 miles S. east of Hurley  
 (distance) (direction) (nearest town)

description of formations encountered	from	to
red clay	0'	10'
white sand & clay streak	10'	25'
Blue Clay	25'	46'
sand	46'	85'

WELL PURPOSE: Home  
 (home, irrigation, municipal, industrial)


- WELL COMPLETION DATA:
- (1) diameter (inches) 2"
  - (2) total depth (feet) 85'
  - (3) static water level (feet) 18' below top of ground.
  - (4) casing PVC, 80' (material), (depth)
  - (size) if telescope see back.
  - (5) screen 5', 80' (length), (depth to top)
  - 2" PVC (size), (material)
  - (6) pump 1 (HP), 12 (yield gpm)
  - ele (type power)
  - (7) electric log no (yes or no)
  - (organization running log)
  - (8) how well bottom plugged B.W.V.

RECEIVED  
 APR 1 1978  
 MISS. BD. OF WATER COMM  
 MISS. BD. OF WATER COMM

DRILLERS REMARKS:

If well telescopes please sketch and show depths.

GROUND LEVEL

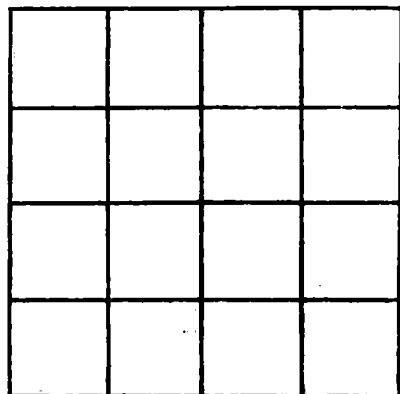

SECTION \_\_\_\_\_

Please indicate well location X.

ADDITIONAL INFORMATION

If more than one screen,  
show locations of each on sketch.