

MISSISSIPPI DEPARTMENT OF NATURAL RESOURCES

Bureau of Land and Water Resources

Southport Mall

P.O. Box 10631

Jackson, Mississippi 39209

WATER WELL DRILLERS LOG

JACKSON
H 2018
6-26-81

June 26 1981 Cosullo Drilling Co. Jackson
 date well completed firm name county well located

LANDOWNER: Walter Hannon
and Percy Hayatt
Big Point, Mo.
 (mailing address)

description of formations encountered	from	to
<u>pipe clay</u>	<u>0</u>	<u>15</u>
<u>soft blue clay</u>	<u>15</u>	<u>22</u>
<u>sand</u>	<u>22</u>	<u>40</u>
<u>red sand</u>	<u>40</u>	<u>45</u>

WELL LOCATION: ?
 sec. 28 T. XV N. R. 5 E.
10 miles North of Big Point
 (distance) (direction) (nearest town)

WELL PURPOSE: Home
 (home, irrigation, municipal, industrial)

- WELL COMPLETION DATA:
- (1) diameter (inches) 2
 - (2) total depth (feet) 45
 - (3) static water level (feet) 9'3" below above top of ground.
 - (4) casing plastic, 40
 (material) (depth)
 (size) If telescope see back.
 - (5) screen 5', 40
 (length) (depth to top)
2", plastic
 (size) (material)
 - (6) pump 1/2, 8
 (HP) (yield gpm)
elec
 (type power)
 - (7) electric log no
 (yes or no)
 (organization running log)
 - (8) how well bottom plugged BPI water


DEPT. OF NATURAL RESOURCES
 BUREAU OF LAND & WATER RESOURCES

NOV 2 - 1981
RECEIVED

DRILLERS REMARKS: _____

If well telescopes please sketch and show depths.

GROUND LEVEL

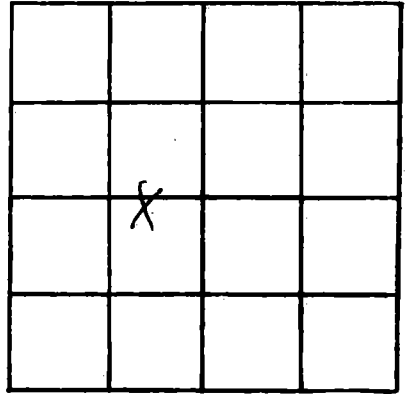

SECTION 28

Please indicate well location X.

ADDITIONAL INFORMATION

If more than one screen,
show locations of each on sketch.