

MISSISSIPPI DEPARTMENT OF NATURAL RESOURCES

Bureau of Land and Water Resources

Southport Mall

P.O. Box 10631

Jackson, Mississippi 39209

WATER WELL DRILLERS LOG

JACKSON
H 7019
10-23-81

10-23-81
date well completed

19 Coast Water Well Sew. Inc.
firm name

Jackson
county/well located

LANDOWNER: R. M. Jones
Rt. 3. Box 178
Passazonby Miss.
(mailing address) 39567

description of formations encountered	from	to
Top soil	0	3'
Red clay	3	25'
Red coarse sand & gravel	25'	86'

WELL LOCATION:
sec. 33 T 5 N R 5 E
1/2 miles S of Big Point
(distance) (direction) (nearest town)

WELL PURPOSE: Home
(home, irrigation, municipal, industrial)

WELL COMPLETION DATA:

- (1) diameter (inches) 2"
- (2) total depth (feet) 86'
- (3) static water level (feet) 18' below top of ground.
- (4) casing PVC, 76' (material) (depth)
 $\frac{76}{40} = 1.9$
- (5) screen 10' (length), 76' (depth to top)
3" (size) PVC (material)
- (6) pump 1/2 hp, 7 (HP) (yield gpm)
Etek (type power)
- (7) electric log No. (yes or no)

DEPT. OF NATURAL RESOURCES
BUREAU OF LAND & WATER RESOURCES

NOV 18 1981


RECEIVED

(8) how well bottom plugged
No. Wash Valve

DRILLERS REMARKS:

If well telescopes please sketch and show depths.

GROUND LEVEL

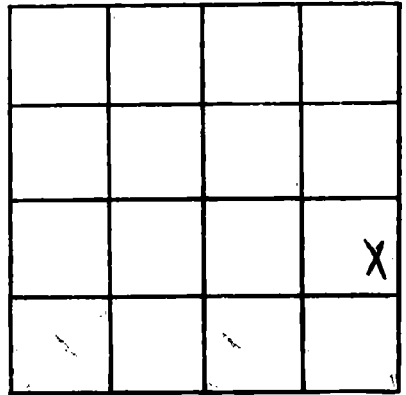

SECTION 33

Please indicate well location X.

ADDITIONAL INFORMATION

If more than one screen, show locations of each on sketch.