

**MISSISSIPPI DEPARTMENT OF NATURAL RESOURCES**  
**Bureau of Land and Water Resources**  
 Southport Mall  
 P.O. Box 10631  
 Jackson, Mississippi 39209  
**WATER WELL DRILLERS LOG**

Jackson  
H2020

11-30-19 St Peice Drilling Co. Jackson  
 date well completed firm name county well located

LANDOWNER: Arthur Jekurst  
Rt 2  
Passagoula Ms  
 (mailing address)

description of formations encountered	from	to
	<u>Top soil</u>	<u>0</u>
<u>sand</u>	<u>10</u>	<u>20</u>
<u>Good sand</u>	<u>20</u>	<u>50</u>

WELL LOCATION:  
 sec. 8 T 5 N R 5 E  
3.5 miles South of Lumberville  
 (distance) (direction) (nearest town)

WELL PURPOSE:  
 (home, irrigation, municipal, industrial)

WELL COMPLETION DATA:

(1) diameter (inches) 2"  
 (2) total depth (feet) 50'  
 (3) static water level (feet) 30' <sup>below</sup> <sub>above</sub> top of ground.  
 (4) casing plastic, 45'  
 (material) (depth)  
0 If telescope see back.  
 (size)  
 (5) screen 5', 50'  
 (length) (depth to top)  
208, plastic  
 (size) (material)  
 (6) pump 1 8  
 (HP) (yield gpm)  
Electric  
 (type power)  
 (7) electric log                       
 (yes or no)  
    
 (organization running log)  
 (8) how well bottom plugged BW

DRILLERS REMARKS:   


DEPT. OF NATURAL RESOURCES  
 BUREAU OF LAND & WATER RESOURCES

MAR 11 1982

**RECEIVED**

If well telescopes please sketch and show depths.

GROUND LEVEL

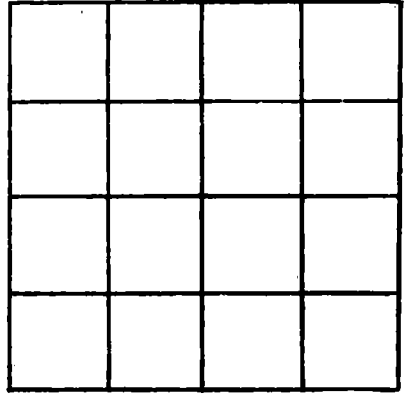

SECTION \_\_\_\_\_

Please indicate well location X.

ADDITIONAL INFORMATION

If more than one screen,  
show locations of each on sketch.