

MISSISSIPPI DEPARTMENT OF NATURAL RESOURCES

Bureau of Land and Water Resources

Southport Mall

P.O. Box 10631

Jackson, Mississippi 39209

WATER WELL DRILLERS LOG

Jackson
H 2021

4-28-82 date well completed
 2 Coast Water Well Sew. Jackson firm name
 One county well located

LANDOWNER: Richard Shumock
2300 Hobbs Shumock Rd.
Saskayoula, Miss.
 (mailing address) 39564

description of formations encountered	from	to
	<u>Top soil</u>	<u>0</u>
<u>Red Clay</u>	<u>3'</u>	<u>19'</u>
<u>Red Coarse sand & gravel</u>	<u>19'</u>	<u>57'</u>

WELL LOCATION:
 sec 28 T 5 S R 5 W
IN miles of Big Point
 (distance) (direction) (nearest town)

WELL PURPOSE: home
 (home, irrigation, municipal, industrial)

WELL COMPLETION DATA:

(1) diameter (inches) 2"

(2) total depth (feet) 57'

(3) static water level (feet) 26' below top of ground. ~~above~~

(4) casing PVC 47'
 (material) (depth)

2"
 (size) If telescope see back.

(5) screen 10' 47'
 (length) (depth to top)

2" PVC
 (size) (material)

(6) pump 1/4 H.P. 9-
 (HPV) (yield gpm)

Elect.
 (type power)

(7) electric log No.
 (yes or no)

 (organization running log)

(8) how well bottom plugged
Backwash Water


DRILLERS REMARKS:

DEPT. OF NATURAL RESOURCES
 BUREAU OF LAND & WATER RESOURCES

MAY 10 1982
 RECEIVED

If well telescopes please sketch and show depths.

GROUND LEVEL

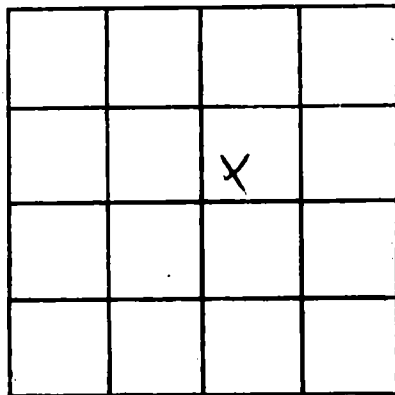

SECTION 28

Please indicate well location X.

ADDITIONAL INFORMATION

If more than one screen, show locations of each on sketch.