

MISSISSIPPI DEPARTMENT OF NATURAL RESOURCES
Bureau of Land and Water Resources
 Southport Mall
 P.O. Box 10631
 Jackson, Mississippi 39209
WATER WELL DRILLERS LOG

Jackson
H 2023

10-1 1982 Pierce Drilling Co. Jackson Co.
 date well completed firm name county well located

LANDOWNER: J. E. Cronier
Big Point, Ms
 (mailing address)

description of formations encountered	from to	
<u>Top Soil</u>	<u>0</u>	<u>10</u>
<u>Sand & Clay</u>	<u>10</u>	<u>25</u>
<u>Good Sand</u>	<u>25</u>	<u>65</u>

WELL LOCATION:
 sec. 28 T. 5 N R. 5 E
5 miles South of Sturley
 (distance) (direction) (nearest town)

WELL PURPOSE:
 (home, Irrigation, municipal, industrial)

- WELL COMPLETION DATA:
- (1) diameter (inches) 2"
 - (2) total depth (feet) 65'
 - (3) static water level (feet) 20' below above top of ground.
 - (4) casing Plastic, 60'
 (material) (depth)
0 if telescope see back.
 (size)
 - (5) screen 5', 65'
 (length) (depth to top)
008, Plastic
 (size) (material)
 - (6) pump 1 10
 (HP) (yield gpm)
Electric
 (type power)
 - (7) electric log (yes or no)
 (organization running log)
 - (8) how well bottom plugged BW

DRILLERS REMARKS:


DEPT. OF NATURAL RESOURCES
 BUREAU OF LAND & WATER RESOURCES

JAN 11 1983

RECEIVED

If well telescopes please sketch and show depths.

GROUND LEVEL

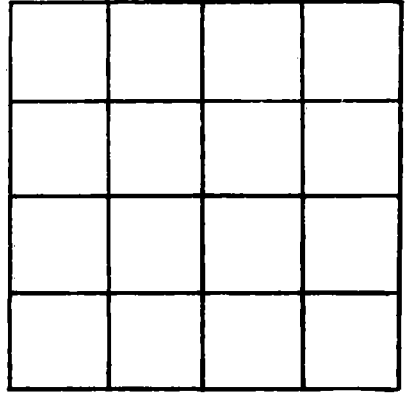

SECTION _____

Please indicate well location X.

ADDITIONAL INFORMATION

If more than one screen, show locations of each on sketch.