

MISSISSIPPI DEPARTMENT OF NATURAL RESOURCES

Bureau of Land and Water Resources

Southport Mall

P.O. Box 10631

Jackson, Mississippi 39209

WATER WELL DRILLERS LOG

Jackson  
H 2024

11-17-82

Coast Water Well Sew. Jackson

date well completed

firm name

county well located

LANDOWNER:

Frank Shorb

description of formations encountered

from

to

Oak Harbor 17629

Top Soil

0 5'

Hwy 613

Red Clay

5' 20'

Pastor only Miss.

(mailing address) 37567

WELL LOCATION:

sec. 2 T. 5 N R. 5 E S. W. Big Point

Red coarse sand & gravel

20' 55'

3/4 miles N of Big Point (distance) (direction) (nearest town)

Red fine sand & shunt of red clay

55' 100'

WELL PURPOSE:

(home, irrigation, municipal, industrial)

Home

Rock 6" Rock

WELL COMPLETION DATA:

- (1) diameter (inches) 2"
- (2) total depth (feet) 260'
- (3) static water level (feet) 54' below top of ground

Blue Clay & Shunt

100' 135'

- (4) casing (material) PVC (depth) 250'

Blue Clay

135' 214'

2" (size) If telescope see back.

Blue Clay & Clay

Shunt 214' 246'

- (5) screen (length) 10' (depth to top) 250'

Rock 8"

2" (size) PVC (material)

Gray coarse sand

246' 260'

- (6) pump (HP) 1/2 (yield gpm) 1

Elect. (type power)

- (7) electric log (yes or no) No

(organization running log)

- (8) how well bottom plugged Back Wash Valve

DRILLERS REMARKS:


DEPT. OF NATURAL RESOURCES BUREAU OF LAND & WATER RESOURCES

DEC 31 1982

RECEIVED

If well telescopes please sketch and show depths.

GROUND LEVEL

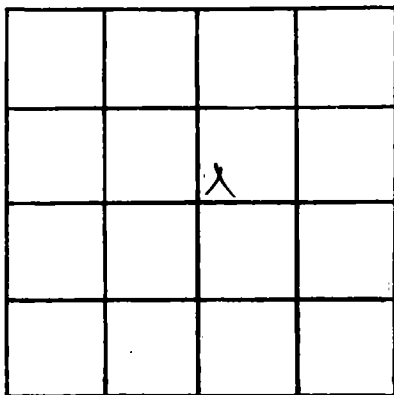

SECTION 21

Please indicate well location X.

ADDITIONAL INFORMATION

If more than one screen,  
show locations of each on sketch.