

MISSISSIPPI DEPARTMENT OF NATURAL RESOURCES
Bureau of Land and Water Resources
 Southport Mall
 P.O. Box 10631
 Jackson, Mississippi 39209
WATER WELL DRILLERS LOG

Jackson
H 2095

11-26 19*82* *Pierce Drilling Co.* *Jackson*
 date well completed firm name county well located


LANDOWNER: <i>Paul Busby,</i>	description of formations encountered	from	to
<i>Big Point Ms</i> (mailing address)	<i>Top Soil</i>	<i>0</i>	<i>10</i>
WELL LOCATION:	<i>Sand</i>	<i>10</i>	<i>25</i>
sec. <i>33</i> T. <i>5</i> N. R. <i>5</i> E.	<i>Clay</i>	<i>25</i>	<i>35</i>
<i>2</i> miles <i>North</i> of <i>Big Point</i> (distance) (direction) (nearest town)	<i>Good Sand</i>	<i>35</i>	<i>70</i>
WELL PURPOSE: (home, irrigation, municipal, industrial)			
WELL COMPLETION DATA:			
(1) diameter (inches) <i>2"</i>			
(2) total depth (feet) <i>70'</i>			
(3) static water level (feet) <i>20'</i> <input checked="" type="checkbox"/> below <input type="checkbox"/> above top of ground.			
(4) casing <i>Plastic</i> , <i>60'</i> (material) (depth) <i>0</i> If telescope see back. (size)			
(5) screen <i>10'</i> , <i>70'</i> (length) (depth to top) <i>008</i> , <i>Plastic</i> (size) (material)			
(6) pump <i>1</i> <i>10</i> (HP) (yield gpm) <i>Electric</i> (type power)			
(7) electric log (yes or no) (organization running log)			
(8) how well bottom plugged <i>BW</i>			

DEPT. OF NATURAL RESOURCES
 BUREAU OF LAND & WATER RESOURCES
 JAN 11 1983
RECEIVED

DRILLERS REMARKS:

If well telescopes please sketch and show depths.

GROUND LEVEL

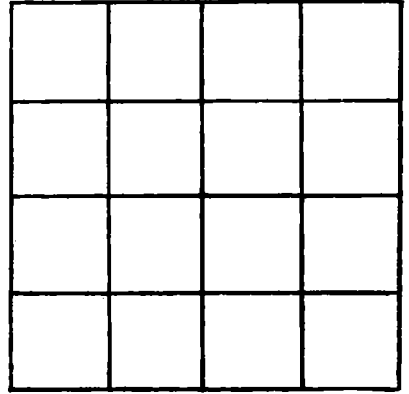

SECTION _____

Please indicate well location X.

ADDITIONAL INFORMATION

If more than one screen,
show locations of each on sketch.