

MISSISSIPPI DEPARTMENT OF NATURAL RESOURCES

Bureau of Land and Water Resources

Southport Mall

P.O. Box 10631

Jackson, Mississippi 39209

WATER WELL DRILLERS LOG

Jackson
H 2827

12-17-82
date well completed

Coast Water Well Sew. Jackson
firm name county well located

LANDOWNER:

Halsey D. Howell
Isles D. Paris Pub # 37
Gautier Miss
(mailing address) 39553

description of formations encountered

from to

Top soil	0	5'
O Sand &	5	90'
B. Clay	90'	165'
M. Sand	165'	182'
B. Clay	182'	240'
M. Sand	240'	277'

WELL LOCATION:

sec 22 T 5 S R 5 W
1 N miles (distance) (direction) of Big Point (nearest town)

WELL PURPOSE: Home
(home, irrigation, municipal, industrial)

WELL COMPLETION DATA:

- (1) diameter (inches) 2"
- (2) total depth (feet) 277
- (3) static water level (feet) 35' below top of ground.
- (4) casing PVC, 267' (material), (depth)
2" (size) if telescope see back.
- (5) screen 10' (length), 267' (depth to top)
2" (size), PVC (material)
- (6) pump R.P. 9 (HP), (yield gpm)
Elec. (type power)
- (7) electric log No. (yes or no)
(organization running log)

(8) how well bottom plugged Backwash Valve

DRILLERS REMARKS:


DEPT. OF NATURAL RESOURCES
BUREAU OF LAND & WATER RESOURCES

JAN 11 1983

RECEIVED

If well telescopes please sketch and show depths.

GROUND LEVEL

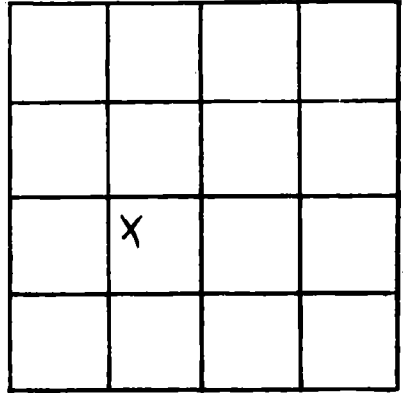

SECTION 22

Please indicate well location X.

ADDITIONAL INFORMATION

If more than one screen, show locations of each on sketch.