

MISSISSIPPI DEPARTMENT OF NATURAL RESOURCES

Bureau of Land and Water Resources

Southport Mall

P.O. Box 10631

Jackson, Mississippi 39209

WATER WELL DRILLERS LOG

Jackson
H 2028

1-5-83
date well completed

Coast Water Well Serv. Jackson
firm name county well located

LANDOWNER:

O'Gwen Clark
3517 Sheffield Rd.
Pascagoula, Miss.
(mailing address) 39267

description of formations encountered

from to

Top	0	2'
Red Clay	2'	16'
Red Coarse sand & gravel	16'	64'
Red Clay & streak of sand	64'	91'
Blue Clay	91'	129'
Gray Coarse sand	129'	150'

WELL LOCATION:

sec. 21 T. 5 S. R. 5 W. 1 miles N of BIG POINT
(distance) (direction) (nearest town)

WELL PURPOSE:

(home, irrigation, municipal, industrial)

Home

WELL COMPLETION DATA:

- (1) diameter (inches) 2"
- (2) total depth (feet) 150'
- (3) static water level (feet) 39' below top of ground.
- (4) casing PVC 140' (material) (depth)
2" (size) if telescope see back.
- (5) screen 10' 140' (length) (depth to top)
2" PVC (size) (material)
- (6) pump 1/2 HP 11 (type power) (y/field gpm)
- (7) electric log No. (yes or no)
- (organization running log)

DEPT. OF NATURAL RESOURCES
BUREAU OF LAND & WATER RESOURCES

FEB 18 1983


RECEIVED

DRILLERS REMARKS:

(8) has well bottom plugged
Jack Wash Valve

If well telescopes please sketch and show depths.

GROUND LEVEL

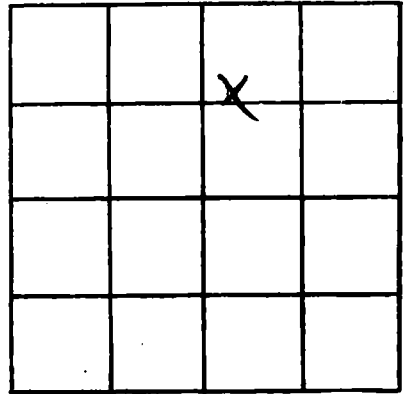

SECTION _____

Please indicate well location X.

ADDITIONAL INFORMATION

If more than one screen, show locations of each on sketch.