

MISSISSIPPI DEPARTMENT OF NATURAL RESOURCES

Bureau of Land and Water Resources

Southport Mall

P.O. Box 10631

Jackson, Mississippi 39209

WATER WELL DRILLERS LOG

Jackson  
H 2029

3-9-1983 date well completed  
23 Coast Water Well Serv. firm name  
Jackson county well located

LANDOWNER

Jimmie Truckent  
4825 Bonnet St.  
Miss Point, Miss.  
(mailing address) 39563

description of formations encountered

	from	to
Top soil	0	2'
Red Clay	2'	10'
Red Coarse sand & gravel	10'	90'
Rock 6"	90'	
Red Coarse sand & gravel	90'	148'
Blue Clay	148'	245'
Rock 245 to 246	245'	246'
Gray Coarse sand	246'	270'

WELL LOCATION:

sec. 21 T. 5 N. R. 5 E. S. 1 W.  
1 miles N of Big Point  
(distance) (direction) (nearest town)

WELL PURPOSE:

Home (home, irrigation, municipal, industrial)

WELL COMPLETION DATA:

- (1) diameter (inches) 2"
- (2) total depth (feet) 270'
- (3) static water level (feet) 70' below top of ground.
- (4) casing PVC 260' (material) (depth)  
2" (size) If telescope see back.
- (5) screen 10' 260' (length) (depth to top)  
2" (size) PVC (material)
- (6) pump 1hp. 7 1/2 (HP) (yield gpm)  
Elec. (type power)
- (7) electric log No - (yes or no)

(organization running log)

(8) How well bottom plugged  
Back water valve

DRILLERS REMARKS:


DEPT. OF NATURAL RESOURCES  
BUREAU OF LAND & WATER RESOURCES

APR 23 1983

RECEIVED

If well telescopes please sketch and show depths.

GROUND LEVEL

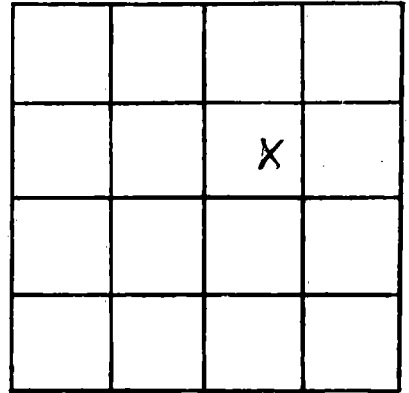

SECTION 21

Please indicate well location X.

ADDITIONAL INFORMATION

If more than one screen, show locations of each on sketch.