

Jackson
 H 7090

MISSISSIPPI
 BOARD OF WATER COMMISSIONERS
 416 North State Street
 Jackson, Mississippi 39201

WATER WELL DRILLERS LOG

5-28-83 *Pierce Drilling Co.* *Jackson*
 date well completed firm name county well located

LANDOWNER: <i>Ronnie Harmon</i>	description of formations encountered	from	to
<i>Hurley, Ms</i> (mailing address)			
	<i>Top soil</i>	<i>0</i>	<i>10</i>
	<i>Sand</i>	<i>10</i>	<i>20</i>
	<i>Good Sand</i>	<i>20</i>	<i>50</i>

WELL LOCATION:
 sec. *22* T. *16* S. R. *5* E.
15 miles *South* of *Agucola*
 (distance) (direction) (nearest town)

WELL PURPOSE:
 (home, irrigation, municipal, industrial)

WELL COMPLETION DATA:
 (1) diameter (inches) *2*
 (2) total depth (feet) *50*
 (3) static water level (feet) *20* *below*
 top of ground. *above*
 (4) casing *Plastic* *45*
 (material) (depth)
0 if telescope see back.
 (size)
 (5) screen *5'* *50'*
 (length) (depth to top)
008 *Plastic*
 (size) (material)
 (6) pump *1* *10*
 (HP) (yield gpm)
Electric
 (type power)
 (7) electric log *(yes or no)*
 (organization running log)
 (8) how well bottom plugged *BW*

DRILLERS-REMARKS:


DEPT. OF NATURAL RESOURCES
 BUREAU OF LAND & WATER RESOURCES

SEP 22 1983

RECEIVED

If well telescopes please sketch and show depths.

GROUND LEVEL

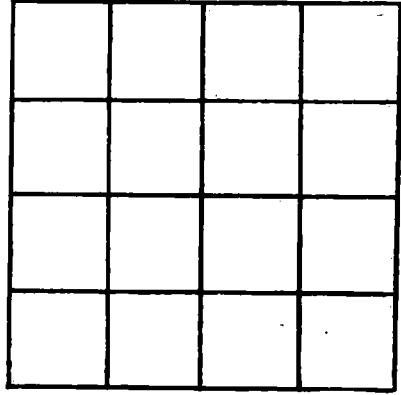

SECTION _____

Please indicate well location X.

ADDITIONAL INFORMATION

If more than one screen, show locations of each on sketch.