

Jackson
H 2031

MISSISSIPPI
 BOARD OF WATER COMMISSIONERS
 416 North State Street
 Jackson, Mississippi 39201

WATER WELL DRILLERS LOG

8-19-1983 Pierce Drilling Co. Jackson
 date well completed firm name county well located

LANDOWNER: Robert Howard
17912 Golf farm rd
Pascagoula, ms
 (mailing address)

description of formations encountered	from	to
<u>Top soil</u>	<u>0</u>	<u>15</u>
<u>Sand</u>	<u>15</u>	<u>35</u>
<u>Clay</u>	<u>35</u>	<u>65</u>
<u>Sand</u>	<u>65</u>	<u>125</u>
<u>Clay</u>	<u>125</u>	<u>380</u>
<u>Good Sand</u>	<u>380</u>	<u>400</u>

WELL LOCATION:
 sec. 14 T. 5 N R. 5 E
5 miles South of Hurley
 (distance) (direction) (nearest town)

WELL PURPOSE:
 (~~home~~) irrigation, municipal, industrial

WELL COMPLETION DATA:

(1) diameter (inches) 2"

(2) total depth (feet) 400'

(3) static water level (feet) 10' ^{below} above top of ground.

(4) casing plastic, 390'
 (material) (depth)

0 if telescope see back.
 (size)

(5) screen 10', 400'
 (length) (depth to top)

008, plastic
 (size) (material)

(6) pump 1 12
 (HP) (yield gpm)

Electric
 (type power)

(7) electric log (yes or no)

(organization running log)

(8) how well bottom plugged BW

DRILLERS REMARKS:


DEPT. OF NATURAL RESOURCES
 BUREAU OF LAND & WATER RESOURCES

SEP 22 1983

RECEIVED

If well telescopes please sketch and show depths.

GROUND LEVEL

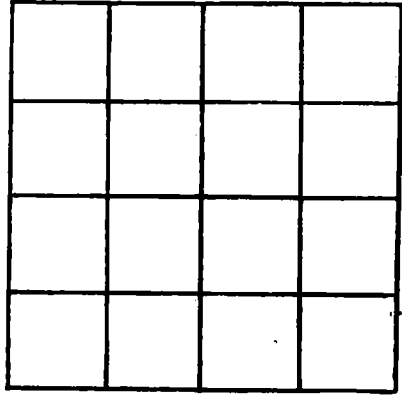

SECTION _____

Please indicate well location X.

ADDITIONAL INFORMATION

Lined area for additional information, consisting of multiple horizontal lines for text entry.

If more than one screen, show locations of each on sketch.