

**MISSISSIPPI DEPARTMENT OF NATURAL RESOURCES**  
**Bureau of Land and Water Resources**  
 Southport Mall  
 P.O. Box 10631  
 Jackson, Mississippi 39209  
**WATER WELL DRILLERS LOG**

Jackson  
H 2838

10-8 1983 Perc Drilling Co Jackson  
 date well completed firm name county well located

LANDOWNER: R.G. Turner

16840 Raymond Shumack Rd  
Pasadena, Ms  
 (mailing address)

description of formations encountered	from	to
<u>Top soil</u>	<u>0</u>	<u>10</u>
<u>Sand &amp; Clay</u>	<u>10</u>	<u>25</u>
<u>Clay</u>	<u>25</u>	<u>50</u>
<u>Gravel Sand</u>	<u>55</u>	<u>70</u>

**WELL LOCATION:**

sec. 27 T 5 N R. 5 E  
 (distance) miles (direction) of (nearest town)  
1 miles East of Big Point

**WELL PURPOSE:**

(home) irrigation, municipal, industrial

**WELL COMPLETION DATA:**

- (1) diameter (inches) 2"
- (2) total depth (feet) 70'
- (3) static water level (feet) 15' below above top of ground.
- (4) casing plastic, 65'  
 (material) (depth)  
0 if telescope see back.  
 (size)
- (5) screen 5', 70'  
 (length) (depth to top)  
gal, plastic  
 (size) (material)
- (6) pump 1 12  
 (HP) (yield gpm)  
Electric  
 (type power)
- (7) electric log (yes or no)

(organization running log)

(8) how well bottom plugged BW

DRILLERS REMARKS:


DEPT. OF NATURAL RESOURCES  
 BUREAU OF LAND & WATER RESOURCES

FEB - 1 1984

**RECEIVED**

If well telescopes please sketch and show depths.

GROUND LEVEL

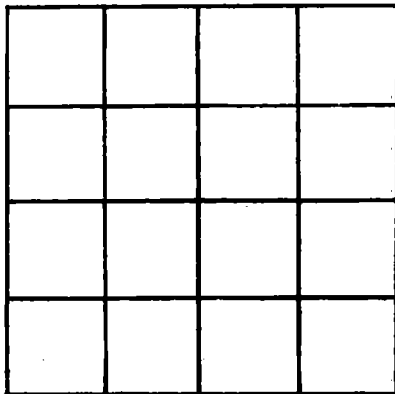

SECTION \_\_\_\_\_

Please indicate well location X.

ADDITIONAL INFORMATION

If more than one screen, show locations of each on sketch.