

MISSISSIPPI DEPARTMENT OF NATURAL RESOURCES

Bureau of Land and Water Resources

Southport Mall

P.O. Box 10631

Jackson, Mississippi 39209

WATER WELL DRILLERS LOG

JACKSON
H2036

4-10-84 19
date well completed

Cross Water Well Sewer Inc. Jackson
firm name county well located

LANDOWNER: James Coleman
15613 Vera Coleman Rd.
Passapatanz Miss.
(mailing address) 39527

description of formations encountered	from	to
Top soil	0	5'
Red Clay	5'	10'
Gray Clay	10'	14'
Black Clay	14'	20'
Blue Clay	20'	27'
Red Coarse sand	27'	60'
Blue Clay	60'	70'

WELL LOCATION:
sec. 32 T 5 N R 5 W
2 miles SE of Big Point
(distance) (direction) (nearest town)

WELL PURPOSE: Home
(home, irrigation, municipal, industrial)

WELL COMPLETION DATA:

(1) diameter (inches) 2"

(2) total depth (feet) 70'

(3) static water level (feet) 15' below top of ground.

(4) casing PVC, 60'
(material) (depth)
2" If telescope see back.
(size)

(5) screen 10', 60'
(length) (depth to top)
2", PVC
(size) (material)

(6) pump _____
(HP) (yield gpm)
(type power)

(7) electric log No
(yes or no)
(organization running log)

2" PVC Tur Pipe

(8) how well bottom plugged
Backwash Valve

DRILLERS REMARKS:


DEPT. OF NATURAL RESOURCES
BUREAU OF LAND & WATER RESOURCES

JUL 10 1984

RECEIVED

If well telescopes please sketch and show depths.

GROUND LEVEL

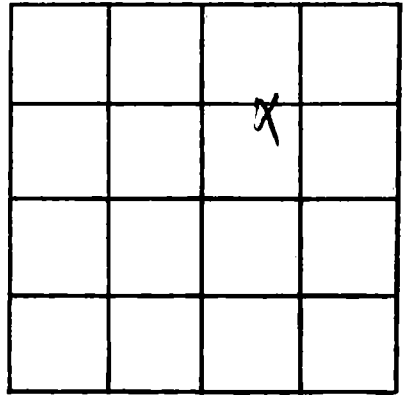

SECTION 32

Please indicate well location X.

ADDITIONAL INFORMATION

If more than one screen, show locations of each on sketch.