

BOARD OF WATER COMMISSIONERS

416 North State Street

Jackson, Mississippi 39201

WATER WELL DRILLERS LOG

42037
3-15-85
date well completed

Pisa Drilling
firm name

Jackson
county well located

LANDOWNER: William McNealy

description of formations encountered	from	to
Top soil	0	10
Clay	10	25
Sand	25	35
Clay	35	45
good Sand	45	70

Pascagoula, MS
(mailing address)

WELL LOCATION:

sec. 35 T-5 N R-5 E
2 miles east of Big Point
(distance) (direction) (nearest town)


WELL PURPOSE:

(home) Irrigation, municipal, industrial)

WELL COMPLETION DATA:

- (1) diameter (inches) 2"
- (2) total depth (feet) 70'
- (3) static water level (feet) 8' below top of ground
- (4) casing plastic, 65' (material) (depth)
- (size) if telescope see back.
- (5) screen 5' length, 70' depth to top
- 006, plastic (size) (material)
- (6) pump 1 HP, 12 yield gpm
- electric (type power)
- (7) electric log (yes or no)
- (organization running log)
- (8) how well bottom plugged BU

DRILLERS REMARKS:

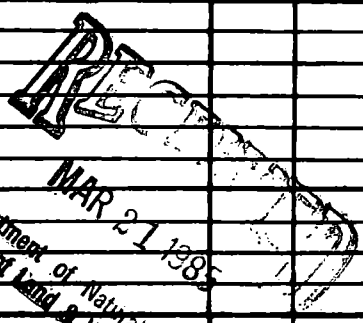

If well telescopes please
sketch and show depths.

GROUND LEVEL

SECTION _____

Please indicate well location X.

ADDITIONAL INFORMATION

If more than one screen,
show locations of each on sketch.