

MISSISSIPPI DEPARTMENT OF NATURAL RESOURCES

Bureau of Land and Water Resources

Southport Mall

P.O. Box 10631

L

Jackson, Mississippi 39209

WATER WELL DRILLERS LOG

Jackson  
H 2038  
4-11-85

4-10 date well completed 19 85 Cross Water Well Sew. firm name Jackson county well located


LANDOWNER: Tram Sports  
17629 Hwy 613  
Pascagoula Miss  
(mailing address) 39562

WELL LOCATION:  
sec 21 T 5 R 5  
1 miles N of Big Point  
(distance) (direction) (nearest town)

WELL PURPOSE: Home  
(home, irrigation, municipal, industrial)

- WELL COMPLETION DATA:
- (1) diameter (inches) 2"
  - (2) total depth (feet) 300'
  - (3) static water level (feet) 40' below above top of ground.
  - (4) casing PVC, 290'  
(material) (depth)
  - 2" if telescope see back.  
(size)
  - (5) screen 10', 290'  
(length) (depth to top)
  - 2" PVC  
(size) (material)
  - (6) pump 1 hp., 1 1/2  
(HP) (yield gpm)
  - Electric  
(type power)
  - (7) electric log No  
(yes or no)
  - (organization running log)
  - (8) how well bottom plugged Back Wash Valve

| description of formations encountered | from | to   |
|---------------------------------------|------|------|
| Top Soil                              | 0    | 3'   |
| Red Clay                              | 3'   | 15'  |
| Coarse white sand                     | 15'  | 85'  |
| Blue Clay                             | 85'  | 170' |
| Blue Clay (shy sand)                  | 170' | 215' |
| Blue Clay (steele)                    | 215' | 250' |
| Coarse grey sand                      | 250' | 262' |
| Blue Clay                             | 262' | 281' |
| Coarse yellow sand                    | 281' | 300' |

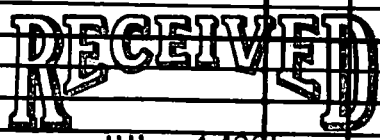


JUL 11 1985

Department of Natural Resources  
Bureau of Land & Water Resources

DRILLERS REMARKS:

If well telescopes please sketch and show depths.

GROUND LEVEL

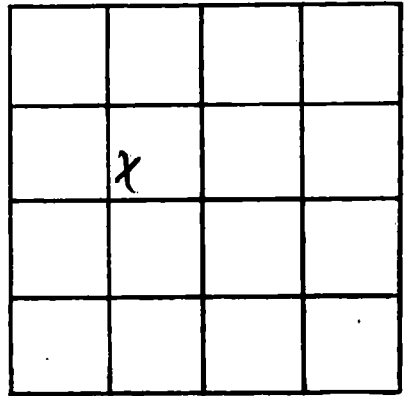

SECTION 21

Please indicate well location X.

ADDITIONAL INFORMATION

If more than one screen, show locations of each on sketch.