

Jackson
 H 2039
 4-16-85

MISSISSIPPI
 BOARD OF WATER COMMISSIONERS
 416 North State Street
 Jackson, Mississippi 39201

L

WATER WELL DRILLERS LOG

4-16-85 date well completed
 Pierce Drilling firm name
 Jackson county well located

LANDOWNER: Dave Sebastian
 Big Point
 Pascagoula Ms
 (mailing address)

description of formations encountered	from	to
top soil	0	15
Clay	15	20
good sand	20	30
Clay	30	40
good sand	40	68

WELL LOCATION:
 sec. 18 T. 5 N R. 5 E
 3 miles south of Hawley
 (distance) (direction) (nearest town)

WELL PURPOSE:
 (home, irrigation, municipal, industrial)

- WELL COMPLETION DATA:
- (1) diameter (inches) 2"
 - (2) total depth (feet) 68'
 - (3) static water level (feet) 20' below top of ground.
 - (4) casing plastic, 58' (material) (depth)
 - 6 (size) if telescope see back.
 - (5) screen 10' (length), 68' (depth to top)
 - 006, plastic (size) (material)
 - (6) pump 1 (HP), 12 (yield gpm)
 - electric (type power)
 - (7) electric log (yes or no)
 - (organization running log)
 - (8) how well bottom plugged BW


RECEIVED

JUL 29 1985

DRILLERS REMARKS:

If well telescopes please sketch and show depths.

GROUND LEVEL

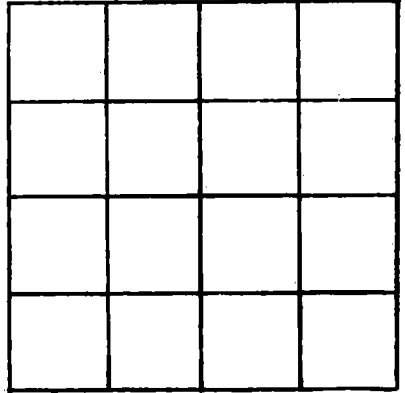

SECTION _____

Please indicate well location X.

ADDITIONAL INFORMATION

If more than one screen,
show locations of each on sketch.