

Jackson  
 H 2040  
 7-19-85

MISSISSIPPI  
 BOARD OF WATER COMMISSIONERS  
 416 North State Street  
 Jackson, Mississippi 39201

L

WATER WELL DRILLERS LOG

7-19-1985 date well completed Pierce Drilling firm name Jackson county well located

LANDOWNER: Herman Finch

description of formations encountered

from

to

Boff Farm Rd.

Passagoula Ms  
 (mailing address)

top soil  
 good sand  
 clay  
 good sand

0 10  
 10 55  
 55 100  
 100 115

WELL LOCATION:

sec. 22 T 5 N R 5 E  
 (distance) 4 miles South of Hurling  
 (direction) (nearest town)

WELL PURPOSE:

(home, irrigation, municipal, industrial)

WELL COMPLETION DATA:

- (1) diameter (inches) 2"
- (2) total depth (feet) 115'
- (3) static water level (feet) 20' below top of ground.
- (4) casing plastic, 105' (material) (depth)  
 0 (size) If telescope see back.
- (5) screen 10', 115' (length) (depth to top)  
 006, plastic (size) (material)
- (6) pump 1 (HP) 12 (yield gpm)  
 electric (type power)
- (7) electric log (yes or no)
- (8) how well bottom plugged BU


RECEIVED  
 JUL 23 1985

DRILLERS REMARKS:

Department of Natural Resources  
 Bureau of Land & Water Resources

If well telescopes please sketch and show depths.

GROUND LEVEL

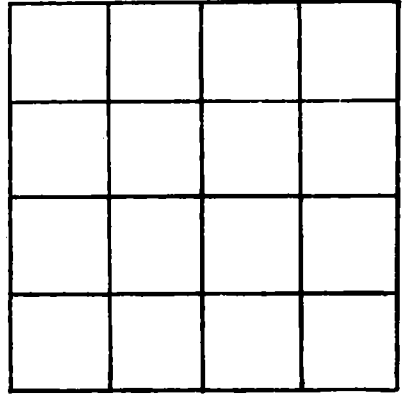

SECTION \_\_\_\_\_

Please indicate well location X.

ADDITIONAL INFORMATION

If more than one screen, show locations of each on sketch.