

MISSISSIPPI DEPARTMENT OF NATURAL RESOURCES

Bureau of Land and Water Resources

Southport Mall

P.O. Box 10631

Jackson, Mississippi 39209

WATER WELL DRILLERS LOG

JACKSON
H 2041

12-8-85 Pierce Drilling Co. Jackson
date well completed firm name county well located

LANDOWNER: Rufus Youngs
9609 Martin Youngs Rd
Pascagoula, ms
(mailing address)

description of formations encountered	from	to
Top Soil	0	10
Clay	10	25
good sand	25	100
Clay	100	170
good sand	170	200

WELL LOCATION:
sec 7 T 6 N 5 R 5 E
(distance) 6 miles (direction) SW of (nearest town) Hurley

WELL PURPOSE:
(home, irrigation, municipal, industrial)

WELL COMPLETION DATA:

- (1) diameter (inches) 2"
- (2) total depth (feet) 200'
- (3) static water level (feet) 20' below above top of ground
- (4) casing plastic, 190' (material) (depth)
- 0 (size) If telescope see back.
- (5) screen 10' 200' (length) (depth to top)
- 006 plastic (size) (material)
- (6) pump 1 10 (HP) (yield gpm)
- electric (type power)
- (7) electric log (yes or no)
- (organization running log)
- (8) how well bottom plugged BU

RECEIVED


JAN 08 1986

Department Bureau of Land & Water Resources

DRILLERS REMARKS:

If well telescopes please sketch and show depths.

GROUND LEVEL

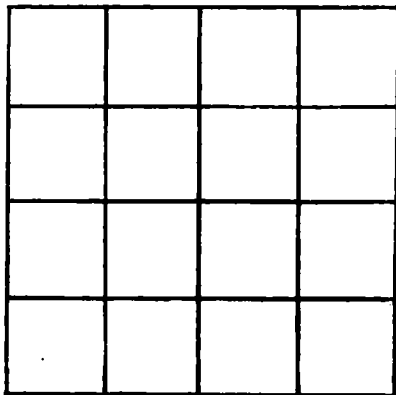

SECTION _____

Please indicate well location X.

ADDITIONAL INFORMATION

If more than one screen, show locations of each on sketch.