

JACKSON
H 2042

MISSISSIPPI
BOARD OF WATER COMMISSIONERS
416 North State Street
Jackson, Mississippi 39201

WATER WELL DRILLERS LOG

2-20-1986 date well completed DePierce Drilling Co firm name Jackson county well located

LANDOWNER: Pat Russler

description of formations encountered	from	to

Hurley, Ms
(mailing address)

top soil	0	10
Sand + Clay	10	20
Good Sand	20	35

WELL LOCATION:
sec. 3 T. 5 N R. 5 E
3 miles South of Hurley
(distance) (direction) (nearest town)

WELL PURPOSE:
(home, irrigation, municipal, industrial)

WELL COMPLETION DATA:

- (1) diameter (inches) 2"
- (2) total depth (feet) 35'
- (3) static water level (feet) 18' below top of ground.
- (4) casing plastic, 30' (material) (depth)
- (size) if telescope see back.
- (5) screen 5' 35' (length) (depth to top)
- (size) (material) 1/2" plastic
- (6) pump 1 (HP), 12 (yield gpm)
- (type power) electric
- (7) electric log (yes or no)
- (organization running log)
- (8) how well bottom plugged BW


RECEIVED
MAR 19 1986

DRILLERS REMARKS:

Department of Natural Resources
Bureau of Land & Water Resources

If well telescopes please sketch and show depths.

GROUND LEVEL

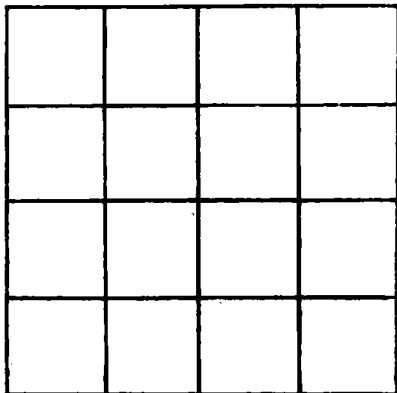

SECTION _____

Please indicate well location X.

ADDITIONAL INFORMATION

If more than one screen, show locations of each on sketch.