

JACKSON
H 2044

MISSISSIPPI
BOARD OF WATER COMMISSIONERS
416 North State Street
Jackson, Mississippi 39201

WATER WELL DRILLERS LOG

7-25 1986 St. Parasolus Co. Jackson
date well completed firm name county well located

LANDOWNER: Clay Boler
Frank Snell, Ed.
Hurley, MS
(mailing address)

WELL LOCATION:
sec. 15 T. 5 N R. 5 E
4 miles South of Hurley
(distance) (direction) (nearest town)

WELL PURPOSE:
(Home, irrigation, municipal, industrial)

WELL COMPLETION DATA:

- (1) diameter (inches) 4"
- (2) total depth (feet) 110'
- (3) static water level (feet) 20' ^{below} _{above} top of ground.
- (4) casing plastic 100'
(material) (depth)
- 0 If telescope see back.
(size)
- (5) screen 10' 110'
(length) (depth to top)
- 006 plastic
(size) (material)
- (6) pump 1 30
(HP) (yield gpm)
- electric
(type power)
- (7) electric log (yes or no)
- (organization running log)
- (8) how well bottom plugged BW

description of formations encountered

from

to

20' soil	0	10
clay	10	20
good sand	20	80
clay	80	90
good sand	90	110

DRILLERS REMARKS:


RECEIVED

AUG 11 1986

Department of Natural Resources
Bureau of Land & Water Resources

If well telescopes please sketch and show depths.

GROUND LEVEL

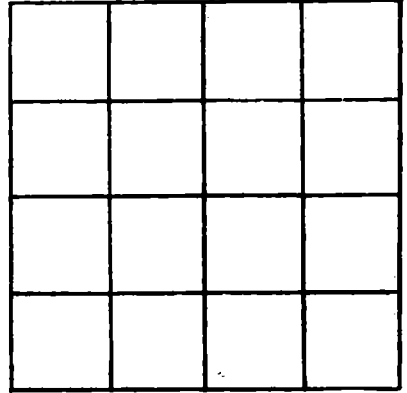

SECTION _____

Please indicate well location X.

ADDITIONAL INFORMATION

If more than one screen, show locations of each on sketch.