

MISSISSIPPI DEPARTMENT OF NATURAL RESOURCES

Bureau of Land and Water Resources

Southport Mall

P.O. Box 10631

Jackson, Mississippi 39209

WATER WELL DRILLERS LOG

JACKSON  
H 2045

9-1-79 date well completed      Ste Peira Drilling Co. firm name      Jackson county well located

LANDOWNER: James Scott  
Hoff Farms Rd.  
Hurley, MS  
(mailing address)

description of formations encountered	depth	
	from	to
Top Soil	0	10
Sand & Clay	10	20
good Sand	20	50
Clay	50	60
good Sand	60	75

WELL LOCATION:  
sec 15 T 5 N R 5 E  
5 miles South of Hurley  
(distance) (direction) (nearest town)

WELL PURPOSE:  
(home, irrigation, municipal, industrial)

- WELL COMPLETION DATA:
- (1) diameter (inches) 3"
  - (2) total depth (feet) 75'
  - (3) static water level (feet) 30' <sup>below</sup> top of ground
  - (4) casing plastic, 70' (material) (depth)
  - (5) screen 5' (length), 75' (depth to top)
  - (6) pump 1 (HP), 12 (yield gpm)
  - (7) electric (type power)
  - (8) electric log (yes or no)
  - (organization running log)
  - (8) how well bottom plugged BW

RECEIVED


OCT 15 1986

Department of Natural Resources  
Bureau of Land & Water Resources

DRILLERS REMARKS:

If well telescopes please sketch and show depths.

GROUND LEVEL

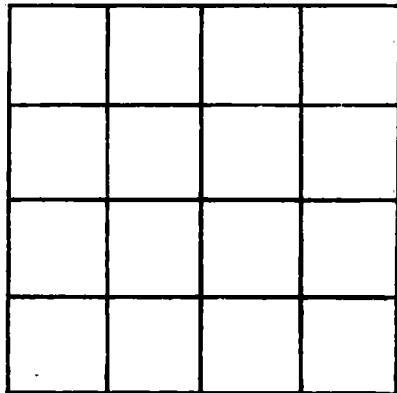

SECTION \_\_\_\_\_

Please indicate well location X.

ADDITIONAL INFORMATION

If more than one screen, show locations of each on sketch.