

**MISSISSIPPI DEPARTMENT OF NATURAL RESOURCES**

Bureau of Land and Water Resources

P.O. Box 10631

Jackson, Mississippi 39209

**WATER WELL DRILLERS LOG**

COUNTY WELL LOCATED <b>Jackson</b>	
WELL NUMBER <b>H 2066</b>	CODED
DATE WELL COMPLETED <b>9-25-80</b>	

PERMIT NUMBER
NAME OF DRILLING FIRM <b>Coast water well</b>

NAME & MAILING ADDRESS OF LANDOWNER <b>Tommy Caver</b> <b>4401 Sermetel Dr.</b> <b>Moss Point MS</b>			
WELL LOCATION:	SEC <b>30</b>	TOWNSHIP <b>5 N</b>	RANGE <b>5 E</b>
DISTANCE <b>4</b>	DIRECTION <b>SE</b>	NEAREST TOWN <b>Wade</b>	
OTHER LANDMARK			
WELL PURPOSE: Home, Irrigation, Municipal, Industrial, Fish Pond, etc. <b>home</b>			

<b>PUMP DATA</b>		
PUMP TYPE (Circle One): Submersible, Turbine, <b>Jet</b> , Flowing Well, Other (Describe):		
POWER TYPE (Circle One): <b>Electric</b> , Tractor, Diesel, Gasoline, Butane, Other (Describe):		
Pump Capacity (GPM) <b>12</b>	No. of Stages <b>2</b>	Setting Depth <b>—</b> FT.
PUMP TEST Well yielded _____ GPM with a drawdown of _____ ft. after _____ hours of pumping		

<b>WELL DATA</b>		
Well Depth <b>70'6.5"</b>	Casing Diameter (In.) <b>2"</b>	Casing Length (Ft.) <b>55'</b>
Type of Casing <b>PVC</b>	Hole Depth <b>70'</b>	Depth to Static Water Level <b>8'</b>
TYPE OF COMPLETION: (Circle One or More): <b>Natural Development</b> , Underreamed, Telescoped, Open Hole, Other		
Top of Lap Pipe or Reduction in Casing <b>FEET</b> IF TELESCOPED OR MORE THAN ONE SCREEN: USE BACK PAGE		

<b>LOG DATA</b>	
TYPE OF LOG RUN (Circle One): Electric, Gamma Ray, Density, Sonic, <b>No Log Run</b> , Other (Describe):	
Name of Organization Running Log	

<b>SCREEN DATA</b>		
Diameter - Inches <b>2"</b>	Length - Feet <b>10'</b>	Slot Size - Inches <b>.010</b>
Screen Type <b>PVC</b>	Depth to Bottom - Feet <b>6.5'</b>	


<b>GEOLOGIC DATA (Office Use Only)</b>			
Surface Elev.	Geologic Unit	Unit Thickness	Depth to Top
Subs. SWL	Date	Analysis	Aquifer Test
Driller's Remarks			

DESCRIPTION OF FORMATIONS ENCOUNTERED	FROM	TO	FORMATIONS ENCOUNTERED	FROM	TO
<b>Top Soil</b>	<b>0</b>	<b>3</b>	<div style="border: 2px solid black; padding: 5px; display: inline-block;"> <b>RECEIVED</b>  <b>NOV 24 1980</b>                      Department of Natural Resources                      Bureau of Land &amp; Water Resources                 </div>		
<b>Red Clay</b>	<b>3</b>	<b>12</b>			
<b>Red Coarse Sand</b>	<b>12</b>	<b>68</b>			
<b>Red Coarse Sand + Gravel</b>	<b>68</b>	<b>70</b>			

IF MORE SPACE IS NEEDED, USE BACK

If well telescopes please sketch and show depths.

GROUND LEVEL

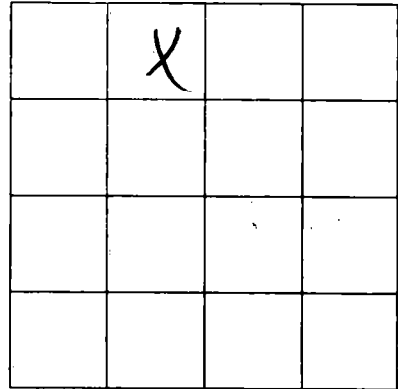

SECTION 30

Please indicate well location X.

ADDITIONAL INFORMATION

Lined area for additional information.

If more than one screen, show location of each on sketch.