

MISSISSIPPI DEPARTMENT OF NATURAL RESOURCES

Bureau of Land and Water Resources

Southport Mall

P.O. Box 10631

Jackson, Mississippi 39209

WATER WELL DRILLERS LOG

JACKSON
H 2047

11-20 1986 date well completed 86 Pierce Drilling Co. firm name Jackson county well located

LANDOWNER: <u>Frankie Brown</u>	description of formations encountered	from	to
<u>Pascagoula MS</u> (mailing address)	<u>top soil</u>	<u>0</u>	<u>10</u>
WELL LOCATION: sec. <u>34</u> T. <u>5</u> N. R. <u>5</u> E. <u>1</u> miles <u>South</u> of <u>Big Point</u> (distance) (direction) (nearest town)	<u>clay</u>	<u>10</u>	<u>20</u>
WELL PURPOSE: <u>home</u> irrigation, municipal, industrial	<u>good sand</u>	<u>20</u>	<u>80</u>
WELL COMPLETION DATA: (1) diameter (inches) <u>2"</u> (2) total depth (feet) <u>80'</u> (3) static water level (feet) <u>3'</u> <u>below</u> top of ground. (4) casing <u>plastic, 75'</u> (material) (depth) <u>0</u> If telescope see back. (size) (5) screen <u>5'</u> , <u>80'</u> (length) (depth to top) <u>006, plastic</u> (size) (material) (6) pump <u>1</u> , <u>12</u> (HP) (yield gpm) <u>electric</u> (type power) (7) electric log <u>(yes or no)</u> <u>(organization running log)</u> (8) how well bottom plugged <u>BW</u>			
DRILLERS REMARKS:			


RECEIVED

SEP 15 1987

Department of Natural Resources
Bureau of Land & Water Resources

If well telescopes please sketch and show depths.

GROUND LEVEL

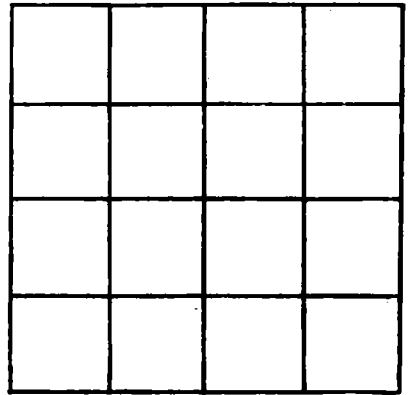

SECTION _____

Please indicate well location X.

ADDITIONAL INFORMATION

If more than one screen,
show locations of each on sketch.