

MISSISSIPPI DEPARTMENT OF NATURAL RESOURCES

Bureau of Land and Water Resources

Southport Mall

P.O. Box 10631

Jackson, Mississippi 39209

WATER WELL DRILLERS LOG

JACKSON  
H 2048

12-5 1987  
date well completed

De Price Drilling Co.  
firm name

Jackson  
county well located

LANDOWNER: Thynn Davis Co  
Wade m s  
Passacoula, m s  
(mailing address)

description of formations encountered	from	to
top soil	0	10
clay	10	30
good sand	30	85
clay	85	120
good sand	120	150

WELL LOCATION:  
sec 27 T 5 N R 5 E  
1 miles South of Big Point  
(distance) (direction) (nearest town)

WELL PURPOSE:  
(home) irrigation, municipal, industrial

WELL COMPLETION DATA:

(1) diameter (inches) 2"

(2) total depth (feet) 150'

(3) static water level (feet) 15' below above top of ground.

(4) casing plastic, 145'  
(material) (depth)

0 If telescope see back.  
(size)

(5) screen 5', 150'  
(length) (depth to top)

006, plastic  
(size) (material)

(6) pump 1 (HP) 12 (yield gpm)  
electric  
(type power)

(7) electric log (yes or no)  
(organization running log)

(8) how well bottom plugged BW


RECEIVED  
SEP 15 1987

Department of Natural Resources  
Bureau of Land & Water Resources

DRILLERS REMARKS:

If well telescopes please sketch and show depths.

GROUND LEVEL

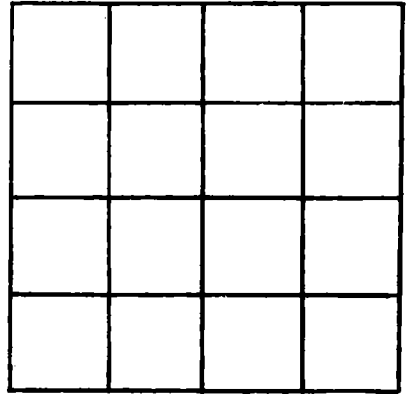

SECTION \_\_\_\_\_

Please indicate well location X.

ADDITIONAL INFORMATION

If more than one screen,  
show locations of each on sketch.