

MISSISSIPPI DEPARTMENT OF NATURAL RESOURCES

Bureau of Land and Water Resources

Southport Mall

P.O. Box 10631

Jackson, Mississippi 39209

WATER WELL DRILLERS LOG

JACKSON  
H 2049

4-10 1987 date well completed 87 Peice Drilling Co. Jackson firm name Jackson county well located

LANDOWNER:

Jackson Co. Ball Park

Pascagoula, MS  
(mailing address)

WELL LOCATION:

sec. 16 T. 5 N R. 5 E  
4 miles South of Merley  
(distance) (direction) (nearest town)

WELL PURPOSE:

(home, irrigation, municipal, industrial)

WELL COMPLETION DATA:

- (1) diameter (inches) 2"
- (2) total depth (feet) 70'
- (3) static water level (feet) 15' below above top of ground.
- (4) casing plastic, 65'  
(material) (depth)
- 0 If telescope see back.  
(size)
- (5) screen 5' 70'  
(length) (depth to top)
- 006, plastic  
(size) (material)
- (6) pump 1 12  
(HP) (yield gpm)
- electric  
(type power)
- (7) electric log                       
(yes or no)
- (organization running log)
- (8) how well bottom plugged BW

description of formations encountered

from

to

<u>top soil</u>	<u>0</u>	<u>10</u>
<u>Silt &amp; Clay</u>	<u>10</u>	<u>20</u>
<u>Sand</u>	<u>20</u>	<u>40</u>
<u>Clay</u>	<u>40</u>	<u>50</u>
<u>gravel sand</u>	<u>50</u>	<u>70</u>

RECEIVED


SEP 15 1987

Department of Natural Resources  
Bureau of Land & Water Resources

DRILLERS REMARKS:

If well telescopes please sketch and show depths.

GROUND LEVEL

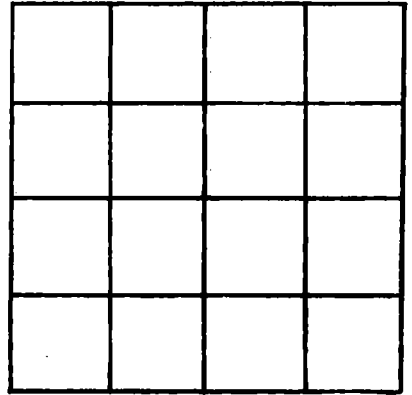

SECTION \_\_\_\_\_

Please indicate well location X.

ADDITIONAL INFORMATION

If more than one screen,  
show locations of each on sketch.