

MISSISSIPPI DEPARTMENT OF NATURAL RESOURCES

Bureau of Land and Water Resources

Southport Mall

P.O. Box 10631

Jackson, Mississippi 39209

WATER WELL DRILLERS LOG

Jackson  
H 2050

6-10-1987 date well completed Purci Drilling Co. firm name Jackson county well located

LANDOWNER: Roy Barlow

Frank Snell Rd.

Hurley, MS

(mailing address)

WELL LOCATION:

sec. 12 T. 5 N R. 5 E  
 5 miles East of Hurley  
 (distance) (direction) (nearest town)

description of formations encountered

from

to

Top Soil	0	10
Clay	10	30
Sand	30	60
Clay	60	150
Sand good	150	175
Clay	175	210
Good Sand	210	240

WELL PURPOSE:


(home, irrigation, municipal, industrial)

WELL COMPLETION DATA:

- (1) diameter (inches) 2"
- (2) total depth (feet) 240'
- (3) static water level (feet) 1' ~~above~~ below top of ground.
- (4) casing Plastic, 230' (material) (depth)  
 0 (size) if telescope see back.
- (5) screen 10' (length), 240' (depth to top)  
 006, plastic (size) (material)
- (6) pump 1 (HP), 12 (yield gpm)  
 electric (type power)
- (7) electric log (yes or no)

(organization running log)

(8) how well bottom plugged BU

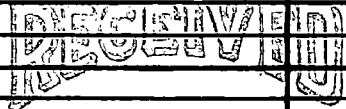


SEP 15 1987

Department of Natural Resources  
 Bureau of Land & Water Resources

DRILLERS REMARKS:

If well telescopes please sketch and show depths.

GROUND LEVEL

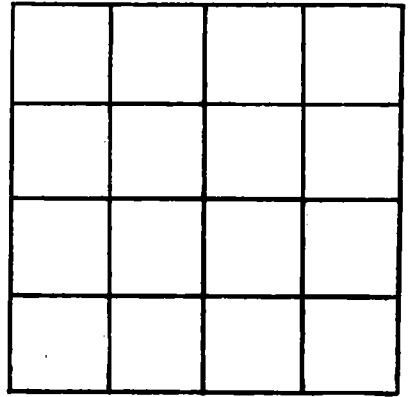

SECTION \_\_\_\_\_

Please indicate well location X.

**ADDITIONAL INFORMATION**

A series of horizontal lines for recording additional information, starting below the 'ADDITIONAL INFORMATION' header and extending to the bottom of the page.

If more than one screen, show locations of each on sketch.