

MISSISSIPPI DEPARTMENT OF NATURAL RESOURCES

Bureau of Land and Water Resources

Southport Mall

P.O. Box 10631

Jackson, Mississippi 39209

WATER WELL DRILLERS LOG

JACKSON
H 2051

7-1-1987 date well completed
Price Drilling Co. firm name
Jackson county well located

LANDOWNER: Delbert Wilkerson
Pascagoula Ms
(mailing address)

WELL LOCATION:
sec. 27 T. 5 N. R. 5 E.
Big Point miles (distance) (direction) (nearest town)

WELL PURPOSE:
(home) irrigation, municipal, industrial

WELL COMPLETION DATA:
(1) diameter (inches) 2"
(2) total depth (feet) 160'
(3) static water level (feet) 30' below above top of ground.
(4) casing plastic, 150'
(material) (depth)
0 If telescope see back.
(size)
(5) screen 10', 160'
(length) (depth to top)
006, plastic
(size) (material)
(6) pump 1 12
(HP) (yield gpm)
electric
(type power)
(7) electric log (yes or no)
(organization running log)
(8) how well bottom plugged BW

description of formations encountered	from	to
Top soil	0	10
Clay	10	20
good sand	20	90
Clay	90	140
good sand	140	160


RECEIVED
SEP 15 1987

Department of Natural Resources
Bureau of Land & Water Resources

DRILLERS REMARKS:

If well telescopes please sketch and show depths.

GROUND LEVEL

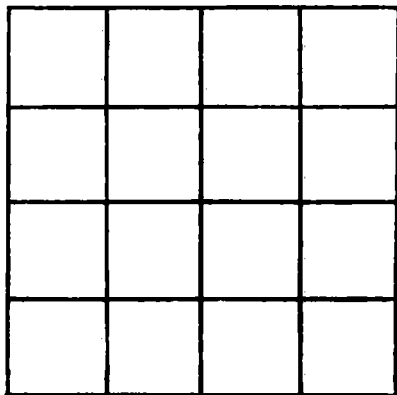

SECTION _____

Please indicate well location X.

ADDITIONAL INFORMATION

If more than one screen,
show locations of each on sketch.