

MISSISSIPPI DEPARTMENT OF NATURAL RESOURCES

Bureau of Land and Water Resources

COUNTY WELL LOCATED Jackson	
WELL NUMBER H 2052	CODED
DATE WELL COMPLETED 7-14-87	

PERMIT NUMBER
NAME OF DRILLING FIRM Pierce Drilling Co.

P.O. Box 10631
Jackson, Mississippi 39209
WATER WELL DRILLERS LOG

NAME & MAILING ADDRESS OF LANDOWNER Floyd Raines		
WELL LOCATION: Pascagoula, Ms		
SECTION	TOWNSHIP	RANGE
3	5	5
DIRECTION: S NEAREST TOWN: Hurley		
DISTANCE: 2 Miles Southeast of Hurley		
OTHER LANDMARK		
WELL PURPOSE: <input checked="" type="checkbox"/> Home, <input type="checkbox"/> Irrigation, <input type="checkbox"/> Municipal, <input type="checkbox"/> Industrial, <input type="checkbox"/> Fish Pond, etc.		

PUMP DATA		
PUMP TYPE (Circle One): Submersible, Turbine, <input checked="" type="radio"/> Jet, Flowing Well, Other (Describe) _____		
POWER TYPE (Circle One): <input checked="" type="radio"/> Electric, Tractor, Diesel, Gasoline, Butane, Other (Describe) _____		
Pump Capacity (GPM) 6	No. of Stages 1	Setting Depth 15 FT.
PUMP TEST Well yielded 6 GPM with a drawdown of 5 ft. after 1 hours of pumping		

WELL DATA		
Well Depth 35'	Casing Diameter (In.) 2"	Casing Length (Ft.) 30'
Type of Casing Plastic	Hole Depth 35'	Depth to Static Water Level 15'
TYPE OF COMPLETION: (Circle One or More): <input checked="" type="checkbox"/> Gravel Packed, <input type="checkbox"/> Underreamed, <input type="checkbox"/> Telescoped, <input type="checkbox"/> Open Hole, <input type="checkbox"/> Other (Describe) _____		
Top of Lap Pipe or Reduction in Casing FEET IF TELESCOPED OR MORE THAN ONE SCREEN: USE BACK PAGE		

LOG DATA	
TYPE OF LOG RUN (Circle One): <input checked="" type="radio"/> No Log Run, <input type="radio"/> Electric, <input type="radio"/> Gamma Ray, <input type="radio"/> Density, <input type="radio"/> Sonic, <input type="radio"/> Neutron, Other (Describe) _____	
Name of Organization Running Log	

SCREEN DATA		
Diameter - Inches 2"	Length - Feet 5'	Slot Size - Inches 006
Screen Type Plastic	Depth to Bottom - Feet 35'	


GEOLOGIC DATA (Office Use Only)			
Surface Elev.	Geologic Unit	Unit Thickness	Depth to Top
Subs. SWL	Date	Analysis	Aquifer Test
Driller's Remarks			

DESCRIPTION OF FORMATIONS ENCOUNTERED	FROM	TO	FORMATIONS (Continued)	FROM	TO
Top Soil	0	15	<div style="font-size: 2em; font-weight: bold; opacity: 0.5;">RECEIVED</div> <div style="font-size: 1.5em; font-weight: bold; margin-top: 10px;">SEP 15 1987</div> <div style="font-size: 0.8em; margin-top: 10px;">Department of Natural Resources Bureau of Land & Water Resources</div>		
Clay	15	20			
Good sand	15	35			

IF MORE SPACE IS NEEDED, USE BACK

If well telescopes please sketch and show depths.

GROUND LEVEL

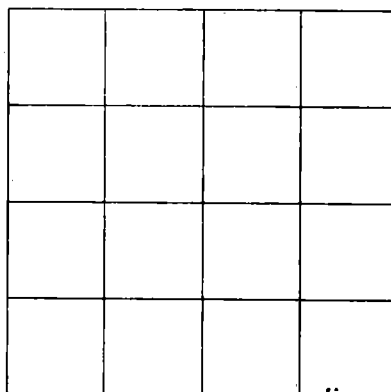

SECTION _____

Please indicate well location X.

ADDITIONAL INFORMATION

If more than one screen,
show location of each on sketch.