

# MISSISSIPPI DEPARTMENT OF NATURAL RESOURCES

Bureau of Land and Water Resources

COUNTY WELL LOCATED	
<i>Jackson</i>	
WELL NUMBER	CODED
<i>H 2055</i>	
DATE WELL COMPLETED	
<i>11-28-87</i>	

PERMIT NUMBER
NAME OF DRILLING FIRM
<i>Pierce Drilling Co</i>

P.O. Box 10631  
Jackson, Mississippi 39209  
**WATER WELL DRILLERS LOG**

NAME & MAILING ADDRESS OF LANDOWNER			
<i>Inez Wrigley</i>			
<i>Frank Small Rd</i>			
<i>Hurley, Ms</i>			
WELL LOCATION	SEC	TOWNSHIP	RANGE
	<i>10</i>	<i>5</i>	<i>5</i> <sup>N</sup> <sub>W</sub>
DISTANCE	DIRECTION	NEAREST TOWN	
<i>3</i>	<i>South</i>	<i>of Hurley</i>	
OTHER LANDMARK			
WELL PURPOSE <input checked="" type="checkbox"/> Home, <input type="checkbox"/> Irrigation, <input type="checkbox"/> Municipal, <input type="checkbox"/> Industrial, <input type="checkbox"/> Fish Pond, etc.			

PUMP DATA		
PUMP TYPE (Circle One):		
Submersible, _____	Turbine, _____	<input checked="" type="radio"/> <u>Jet</u> _____
Other (Describe) _____		
POWER TYPE (Circle One):		
<input checked="" type="radio"/> <u>Electric</u> , _____	Tractor, _____	Diesel, _____
Other (Describe) _____		
Pump Capacity (GPM)	No. of Stages	Setting Depth
<i>12</i>	<i>2</i>	<i>40</i> FT.
PUMP TEST		
Well yielded <i>12</i> GPM with		
a drawdown of <i>5</i> ft.		
after <i>1</i> hours of pumping		

WELL DATA		
Well Depth	Casing Diameter (In.)	Casing Length (Ft.)
<i>80'</i>	<i>2"</i>	<i>75'</i>
Type of Casing	Hole Depth	Depth to Static Water Level
<i>Plastic</i>	<i>80'</i>	<i>20'</i>
TYPE OF COMPLETION: (Circle One or More):		
Gravel Packed, _____ Underreamed, _____ Telescoped, _____		
<input checked="" type="radio"/> <u>Natural Development</u> , _____ Open Hole, _____ Other _____		
Top of Lap Pipe or Reduction in Casing		
<i>none</i> FEET <input type="checkbox"/> IF TELESCOPED OR MORE THAN ONE SCREEN: USE BACK-PAGE		

LOG DATA	
TYPE OF LOG RUN (Circle One):	
Electric, _____	<input checked="" type="radio"/> <u>No Log Run</u> , _____
Gamma Ray, _____ Density, _____ Sonic, _____ Neutron, _____	
Other (Describe) _____	
Name of Organization Running Log	

SCREEN DATA		
Diameter - Inches	Length - Feet	Slot Size - Inches
<i>2"</i>	<i>5'</i>	<i>006</i>
Screen Type	Depth to Bottom - Feet	
<i>Plastic</i>	<i>80'</i>	


GEOLOGIC DATA (Office Use Only)			
Surface Elev.	Geologic Unit	Unit Thickness	Depth to Top
Subs. SWL	Date	Analysis	Aquifer Test
Driller's Remarks			

DESCRIPTION OF FORMATIONS ENCOUNTERED	FROM	TO	FORMATIONS (Continued)	FROM	TO
<i>Top Soil</i>	<i>0</i>	<i>10</i>	<b>REGISTERED</b>  <i>JAN 5 1988</i>  Department of Natural Resources Bureau of Land & Water Resources		
<i>Clay</i>	<i>10</i>	<i>20</i>			
<i>good Sand</i>	<i>20</i>	<i>40</i>			
<i>Clay</i>	<i>40</i>	<i>60</i>			
<i>good Sand</i>	<i>60</i>	<i>80</i>			

IF MORE SPACE IS NEEDED, USE BACK

If well telescopes please  
sketch and show depths.

GROUND LEVEL

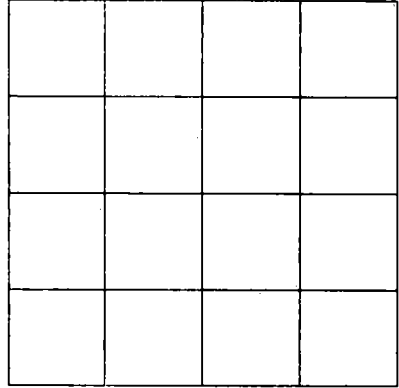

SECTION \_\_\_\_\_

Please indicate well location X.

ADDITIONAL INFORMATION

If more than one screen,  
show location of each on sketch.