

MISSISSIPPI DEPARTMENT OF NATURAL RESOURCES

Bureau of Land and Water Resources

Southport Mall

P.O. Box 10631

Jackson, Mississippi 39209

WATER WELL DRILLERS LOG

JACKSON
H 9059

1-18-88
date well completed

Satterlin & W Lee
firm name

Jackson
county well located

LANDOWNER: Smith
Hwy 613
Hurley Ma 39555
(mailing address)

description of formations encountered	from	to
<u>Sandy soil</u>	<u>0</u>	<u>5</u>
<u>Clay</u>	<u>5</u>	<u>20</u>
<u>Fine sand</u>	<u>20</u>	<u>30</u>
<u>Coarse sand</u>	<u>30</u>	<u>40</u>

WELL LOCATION:
sec. 4 T. 5 N R. 5 E
5 miles S of Hurley
(distance) (direction) (nearest town)

WELL PURPOSE:
(home, irrigation, municipal, industrial)

- WELL COMPLETION DATA:
- (1) diameter (inches) 2"
 - (2) total depth (feet) 40
 - (3) static water level (feet) 9 below top of ground. above
 - (4) casing PVC, 35'
(material) (depth)
1 (size) if telescope see back.
 - (5) screen 5', 35'
(length) (depth to top)
2", PVC
(size) (material)
 - (6) pump 1/2 (HP) 8 (yield gpm)
AC (type power)
 - (7) electric log NO
(yes or no)
 - (organization running log)
 - (8) how well bottom plugged BACK - WASH VALVE

RECEIVED


FEB 19 1988

Department of Natural Resources
Bureau of Land & Water Resources

DRILLERS REMARKS:

If well telescopes please sketch and show depths.

GROUND LEVEL

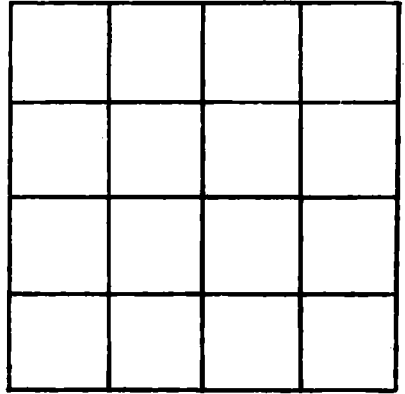

SECTION _____

Please indicate well location X.

ADDITIONAL INFORMATION

If more than one screen,
show locations of each on sketch.