

MISSISSIPPI DEPARTMENT OF NATURAL RESOURCES

Bureau of Land and Water Resources

Southport Mall

P.O. Box 10631

Jackson, Mississippi 39209

WATER WELL DRILLERS LOG

JACKSON
H 2061

5/9/88
date well completed

19 Sutton W. Wise
firm name

Jackson
county well located

LANDOWNER:

B. Smith

description of formations encountered

from

to

Feltz 613

hard soil

0

3

Osceola
(mailing address)

clay

25

40

shaly clay

40

65

sand

65

95

WELL LOCATION:

sec. 5 T. 5 N. R. 5 E.
5 miles ms of Furley
(distance) (direction) (nearest town)

WELL PURPOSE:

(home, irrigation, municipal, industrial)

WELL COMPLETION DATA:

(1) diameter (inches) 2"
(2) total depth (feet) 95'
(3) static water level (feet) 15 below above
top of ground.

(4) casing PVC 85'
(material) (depth)

(size) If telescope see back.

(5) screen 10 85'
(length) (depth to top)

2' PVC
(size) (material)

(6) pump 1 11
(HP) (yield gpm)

AC
(type power)

(7) electric log N
(yes or no)

(organization running log)

(8) how well bottom plugged BWV

RECEIVED


JUN 08 1988

Department of Natural Resources
Bureau of Land & Water Resources

DRILLERS REMARKS:

If well telescopes please sketch and show depths.

GROUND LEVEL

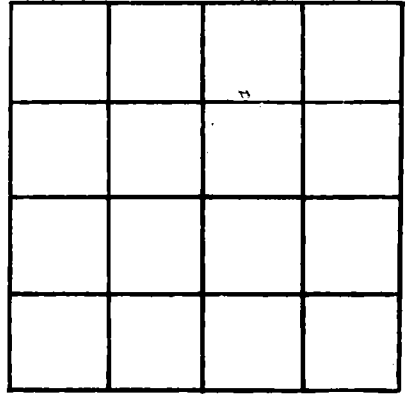

SECTION _____

Please indicate well location X.

ADDITIONAL INFORMATION

If more than one screen, show locations of each on sketch.