

Jackson
H 2062

MISSISSIPPI DEPARTMENT OF NATURAL RESOURCES
 Bureau of Land and Water Resources
 Southport Mall
 P.O. Box 10631
 Jackson, Mississippi 39209
WATER WELL DRILLERS LOG

5-17 19 88 date well completed
Jackson firm name
Jackson county well located

LANDOWNER:
Albert Dill
8501 Leon Creek Rd
Jackson, Miss (mailing address)
 WELL LOCATION:
 sec 10 T 5 N R 5 E
6 miles SO of Harley
 (distance) (direction) (nearest town)

description of formations encountered	from	to
<u>Fine sand</u>	<u>0</u>	<u>20</u>
<u>medium</u>	<u>20</u>	<u>40</u>
<u>Clay</u>	<u>40</u>	<u>55</u>
<u>Coarse sand</u>	<u>55</u>	<u>85</u>

WELL PURPOSE: Irrigation
 (home, irrigation, municipal, industrial)

- WELL COMPLETION DATA:
- (1) diameter (inches) 2"
 - (2) total depth (feet) 85'
 - (3) static water level (feet) 4' below top of ground.
 - (4) casing PVC 75'
 (material) (depth)
2"
 (size) if telescope see back.
 - (5) screen 10' 75'
 (length) (depth to top)
2" PVC
 (size) (material)
 - (6) pump 1 10
 (HP) (yield gpm)
AC
 (type power)
 - (7) electric log N
 (yes or no)
 (organization running log)
 - (8) how well bottom plugged BWV

DRILLERS REMARKS:


RECEIVED

JUN 08 1988

Department of Natural Resources
 Bureau of Land & Water Resources

If well telescopes please sketch and show depths.

GROUND LEVEL

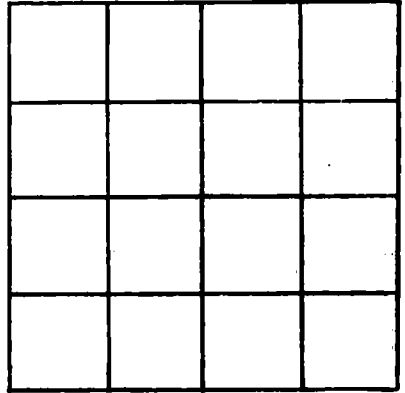

SECTION _____

Please indicate well location X.

ADDITIONAL INFORMATION

If more than one screen, show locations of each on sketch.