

MISSISSIPPI DEPARTMENT OF NATURAL RESOURCES

Bureau of Land and Water Resources

Southport Mall

P.O. Box 10631

Jackson, Mississippi 39209

WATER WELL DRILLERS LOG

Jackson  
H 2066

12/17/88

date well completed

19 Southern Water Well Drillers Jackson  
firm name county well located

LANDOWNER: Mrs. Barba

Hwy 614

Hurley ms  
(mailing address)

description of formations encountered

from

to

top soil  
sand

0 5  
5 25

WELL LOCATION:

sec. 4 T 5 N R 5 E  
Hurley miles of (nearest town)

WELL PURPOSE: Home  
(home, irrigation, municipal, industrial)

WELL COMPLETION DATA:

- (1) diameter (inches) 2"
- (2) total depth (feet) 25'
- (3) static water level (feet) 8' below top of ground.
- (4) casing 2" (material), 25' (depth)

(size) If telescope see back.

- (5) screen 5' (length), 20' (depth to top)
- 2" (size), PVC (material)

- (6) pump 1/2 (HP), 8 (yield gpm)
- AC (type power)

- (7) electric log N/A (yes or no)
- N/A (organization running log)

- (8) how well bottom plugged BWV

RECEIVED


FEB 8 1989

Department of Natural Resources  
Bureau of Land & Water Resources

DRILLERS REMARKS:

If well telescopes please sketch and show depths.

GROUND LEVEL

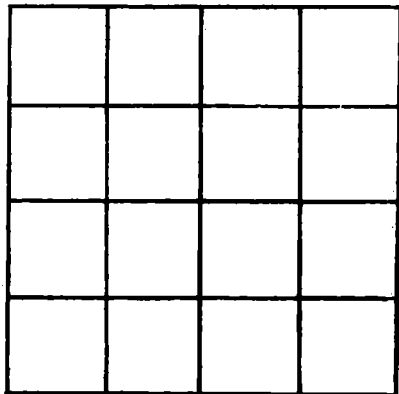

SECTION \_\_\_\_\_

Please indicate well location X.

ADDITIONAL INFORMATION

If more than one screen, show locations of each on sketch.