

MISSISSIPPI DEPARTMENT OF NATURAL RESOURCES

Bureau of Land and Water Resources

P.O. Box 10631

Jackson, Mississippi 39209

WATER WELL DRILLERS LOG

COUNTY WELL LOCATED JACKSON	
WELL NUMBER H 2068	CODED
DATE WELL COMPLETED 30 NOV 88	

PERMIT NUMBER 0-485
NAME OF DRILLING FIRM CORE TRIP
WRIGHT - STOUT

NAME & MAILING ADDRESS OF LANDOWNER B. E. FAULKNER			
RT. 7, Box 571-B			
MOBILE, AL. 36608			
WELL LOCATION:	SEC	TOWNSHIP	RANGE
	5	5	4
		N	E
		S	W
DISTANCE	DIRECTION		NEAREST TOWN
10 Miles	EAST of		WADE
OTHER LANDMARK 200 YARDS WEST OF ROBERTS CHAPEL 1/2 MILE NORTH OF HWY 614			
WELL PURPOSE: Home, Irrigation, Municipal, Industrial, Fish Pond, etc. HOME			

PUMP DATA		
PUMP TYPE (Circle One): Submersible, Turbine, Jet Flowing Well, Other (Describe) _____		
POWER TYPE (Circle One): Electric , Tractor, Diesel, Gasoline, Butane, Other (Describe) _____		
Pump Capacity (GPM) 25	No. of Stages 2	Setting Depth 80 FT.
PUMP TEST		
Well yielded 10 GPM with a drawdown of 25 ft. after 30 MIN hours of pumping		

WELL DATA		
Well Depth 105 106.5	Casing Diameter (in.) 2"	Casing Length (Ft.) 95' 59.5"
Type of Casing PVC	Hole Depth 112'	Depth to Static Water Level 40'
TYPE OF COMPLETION: (Circle One or More): Natural Development , Underreamed, Telescoped, Open Hole, Other (Describe) _____		
Top of Lap Pipe or Reduction in Casing FEET IF TELESCOPED OR MORE THAN ONE SCREEN: USE BACK PAGE		

LOG DATA	
TYPE OF LOG RUN (Circle One): No Log Run , Electric, Gamma Ray, Density, Sonic, Neutron, Other (Describe) _____	
Name of Organization Running Log	

SCREEN DATA		
Diameter - Inches 2"	Length - Feet 10'	Slot Size - Inches #10
Screen Type PVC		Depth to Bottom of Feet 95' 105.5"


GEOLOGIC DATA (Office Use Only)			
Surface Elev.	Geologic Unit	Unit Thickness	Depth to Top
Subs. SWL	Date	Analysis	Aquifer Test
Driller's Remarks Pump to be installed later by RECEIVED			

DESCRIPTION OF FORMATIONS ENCOUNTERED	FROM	TO	FORMATION (continued) 1989	FROM	TO
Red Clay	0	5	MEDIUM GREY SAND	88	94
COURSE White SAND	5	7	COURSE White SAND		109
Red Clay	7	12	GRAVEL		→ ?
COURSE SAND	12	48			
COURSE GRAVEL	48	51			
Hard Clay	51	55			
Fine Sand + Clay streaks	55	60			
MED SAND	60	65			
Hard GREY Clay	65	68			
SOFT GREY Clay + SAND	68	75			
FINE GREY SAND					

IF MORE SPACE IS NEEDED, USE BACK

If well telescopes please sketch and show depths.

GROUND LEVEL

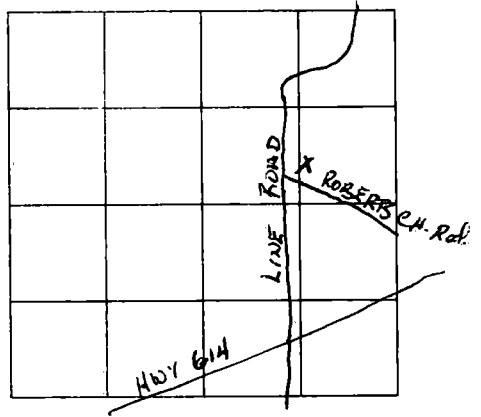

SECTION 5

Please indicate well location X.

ADDITIONAL INFORMATION

If more than one screen,
show location of each on sketch.