

MISSISSIPPI DEPARTMENT OF NATURAL RESOURCES
Bureau of Land and Water Resources
 Southport Mall
 P.O. Box 10631
 Jackson, Mississippi 39209
WATER WELL DRILLERS LOG

Jackson
H 2072


date well completed 9-30-89 19 Southern Water Well firm name Jackson county well located

LANDOWNER:	description of formations encountered	from	to
<u>Mrs Harder</u>	<u>Clay</u>	<u>0</u>	<u>10</u>
<u> Hwy 613 Hurley</u> (mailing address)	<u>Sand</u>	<u>10</u>	<u>25</u>
WELL LOCATION:			
sec. <u>17</u> T <u>5</u> N R <u>5</u> E <u>5</u> miles <u>N</u> of <u>Hurley</u> (distance) (direction) (nearest town)			
WELL PURPOSE: <u>Home</u> (home, irrigation, municipal, industrial)			
WELL COMPLETION DATA:			
(1) diameter (inches) <u>2"</u>			
(2) total depth (feet) <u>25'</u>			
(3) static water level (feet) <u>10'</u> <u>below</u> above top of ground.			
(4) casing <u>PVC</u> , <u>20'</u> (material) (depth) (size) if telescope see back.			
(5) screen <u>5'</u> , <u>20'</u> (length) (depth to top)			
<u>2"</u> , <u>PVC</u> (size) (material)			
(6) pump <u>None</u> (HP) (yield gpm) (type power)			
(7) electric log <u>(yes or no)</u> (organization running log)			
(8) how well bottom plugged <u>BLW</u>			
DRILLERS REMARKS:			

MISSISSIPPI DEPARTMENT OF NATURAL RESOURCES
 Bureau of Land and Water Resources

If well telescopes please sketch and show depths.

GROUND LEVEL

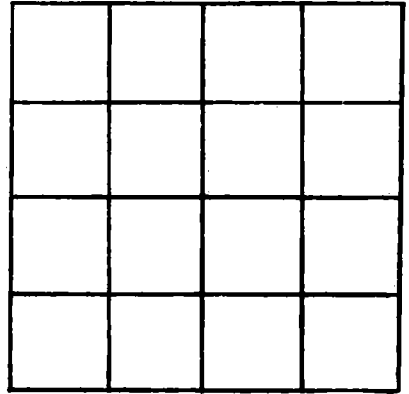

SECTION _____

Please indicate well location X.

ADDITIONAL INFORMATION

If more than one screen, show locations of each on sketch.