

MISSISSIPPI DEPARTMENT OF NATURAL RESOURCES

Bureau of Land and Water Resources

Southport Mall

P.O. Box 10631

Jackson, Mississippi 39209

WATER WELL DRILLERS LOG

RECEIVED

MAY 9 1990

Department of Natural Resources

Bureau of Land & Water Resources

Jackson
H 2674

3-14-90

Southern W/Well Dr

Jackson

date well completed

firm name

county well located

LANDOWNER: M. Douglas

description of formations encountered

from

to

Hwy 613

top soil

0

5

Big Bent
(mailing address)

loamy soil

5

30

clay

30

50

sand

50

75

WELL LOCATION:

sec. 7 T. 5 N. R. 5 E

(S)

(W)

15 miles N of

(direction)

Madison (nearest town)

WELL PURPOSE: none

(home, irrigation, municipal, industrial)

WELL COMPLETION DATA:

(1) diameter (inches) 2"

(2) total depth (feet) 75'

(3) static water level (feet) 20' below top of ground.

(4) casing PVC 70' (material) (depth)

(size) If telescope see back.

(5) screen 5' 70' (length) (depth to top)

2" PVC (size) (material)

(6) pump none installed (HP) (yield gpm)

N/A (type power)

(7) electric log (yes or no)


(organization running log)

(8) how well bottom plugged BWU

DRILLERS REMARKS:

If well telescopes please
sketch and show depths.

GROUND LEVEL

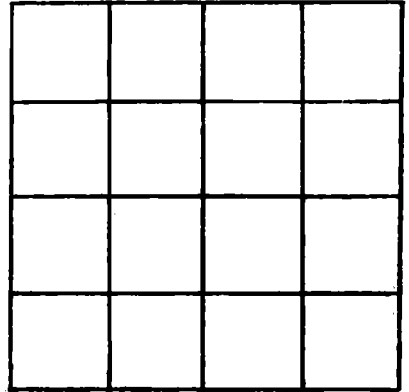

SECTION _____

Please indicate well location X.

ADDITIONAL INFORMATION

If more than one screen,
show locations of each on sketch.