

MISSISSIPPI DEPARTMENT OF NATURAL RESOURCES

Bureau of Land and Water Resources

Southport Mall

P.O. Box 10631

Jackson, Mississippi 39209

WATER WELL DRILLERS LOG

JACKSON
H 2076

4/10/90
date well completed


Sullivan W/Well
firm name

Jackson
county well located

LANDOWNER: <u>Mr Fisher</u> <u>Delf Farms Rd</u> <u>Hurley</u> (mailing address)	description of formations encountered	from	to
WELL LOCATION: sec. <u>15</u> T. <u>5</u> N R. <u>5</u> E <u>17</u> miles <u>N</u> of <u>McBrist</u> (distance) (direction) (nearest town)	<u>sand</u>	<u>0</u>	<u>45</u>
WELL PURPOSE: <u>Home</u> (home, irrigation, municipal, industrial)			
WELL COMPLETION DATA: (1) diameter (inches) <u>2"</u> (2) total depth (feet) <u>45'</u> (3) static water level (feet) <u>10</u> ^{below} above top of ground. (4) casing <u>PVC</u> , <u>40</u> (material) (depth) (size) if telescope see back. (5) screen <u>5'</u> , <u>45'</u> (length) (depth to top) <u>2"</u> , <u>PVC</u> (size) (material) (6) pump <u>No pump installed</u> (HP) (yield gpm) (type power) (7) electric log _____ (yes or no) (organization running log) (8) how well bottom plugged <u>BWU</u>			
DRILLERS REMARKS:			

If well telescopes please sketch and show depths.

GROUND LEVEL

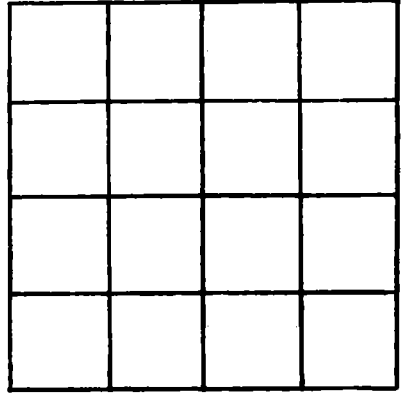

SECTION _____

Please indicate well location X.

ADDITIONAL INFORMATION

If more than one screen,
show locations of each on sketch.