

MISSISSIPPI DEPARTMENT OF NATURAL RESOURCES

Bureau of Land and Water Resources

Southport Mall

P.O. Box 10631

Jackson, Mississippi 39209

WATER WELL DRILLERS LOG

Jackson
11 7081

12-1-90
date well completed

Sawden Water Well Jackson
firm name

Jackson
county well located

LANDOWNER: Mr Dug
Frank Snell Rd
Pocahontas
(mailing address)

description of formations encountered	from	to
<u>bedrock</u>	<u>0</u>	<u>20</u>
<u>sandy clay</u>	<u>10</u>	<u>65</u>
<u>clay</u>	<u>65</u>	<u>80</u>
<u>sand</u>	<u>80</u>	<u>108</u>

WELL LOCATION:
sec. 11 T 5 N R 3 E
15 miles N of Marion
(distance) (direction) (nearest town)

WELL PURPOSE: Home
(home, irrigation, municipal, industrial)

- WELL COMPLETION DATA:
- (1) diameter (inches) 2"
 - (2) total depth (feet) 108'
 - (3) static water level (feet) 20 below above top of ground.
 - (4) casing PVC 98'
(material) (depth)
2' (size) if telescope see back.
 - (5) screen 10' 98'
(length) (depth to top)
2" (size) PVC (material)
 - (6) pump 1 12
(HP) (yield gpm)
PVC (type power)
 - (7) electric log no
(yes or no)
(organization running log)
 - (8) how well bottom plugged BWL

RECEIVED


FEB 10 1991

Dept. of Environmental Quality
Bureau of Land & Water Resources

DRILLERS REMARKS:

If well telescopes please sketch and show depths.

GROUND LEVEL

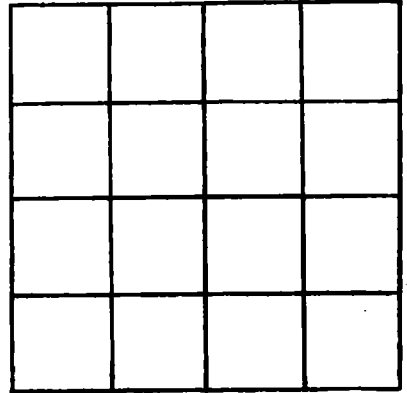

SECTION _____

Please indicate well location X.

ADDITIONAL INFORMATION

If more than one screen, show locations of each on sketch.