

MISSISSIPPI DEPARTMENT OF NATURAL RESOURCES

Bureau of Land and Water Resources

Southport Mall

P.O. Box 10631

Jackson, Mississippi 39209

WATER WELL DRILLERS LOG

JACKSON
H 2086

5/20/91 19 Southwell Jackson
date well completed firm name county well located

LANDOWNER: Mrs. Snel
Frank Snel Rd
Hurley
(mailing address)

description of formations encountered	from	to
clay	0	20
sands, clay	20	65
middle clay	65	85
sand	85	105

WELL LOCATION:
sec. 11 T. S N. R. S E
20 miles N of Bayou La Poudre
(distance) (direction) (nearest town)

WELL PURPOSE:
(Home, Irrigation, municipal, Industrial)

WELL COMPLETION DATA:

(1) diameter (inches) 2"

(2) total depth (feet) 105'

(3) static water level (feet) 26' ^{below} above top of ground.

(4) casing PVC, 95'
(material) (depth)
(size) If telescope see back.

(5) screen 10', 95'
(length) (depth to top)
2", PVC
(size) (material)

(6) pump 1, 10
(HP) (yield gpm)
AC
(type power)

(7) electric log NO
(yes or no)
(organization running log)

(8) how well bottom plugged BWD

RECEIVED


JUL 11 1991

Dept. of Environmental Quality
Bureau of Land & Water Resources

DRILLERS REMARKS:

If well telescopes please sketch and show depths.

GROUND LEVEL

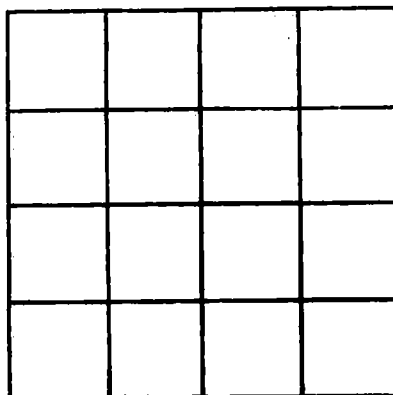

SECTION _____

Please indicate well location X.

ADDITIONAL INFORMATION

If more than one screen, show locations of each on sketch.