

MISSISSIPPI DEPARTMENT OF ENVIRONMENTAL QUALITY

Office of Land and Water Resources

P. O. Box 10631
Jackson, MS 39289-0631

WATER WELL DRILLERS LOG

COUNTY, WELL LOCATED Jackson
 WELL NUMBER H-2100 CODED
 DATE WELL COMPLETED 3-22-93

PERMIT NUMBER
 NAME OF DRILLING FIRM Coast Water Well Dr. Inc.

NAME & MAILING ADDRESS OF LANDOWNER
Helen Mason
14376 Old Hwy. 67
Biloxi, Ms. 39532
 WELL LOCATION: SEC 26 TOWNSHIP 15S RANGE 10W
 DISTANCE 3 Miles DIRECTION NE NEAREST TOWN WoolMARKET
 OTHER LANDMARK
 WELL PURPOSE: Home, Irrigation, Municipal, Industrial, Fish Pond, etc.

PUMP DATA
 PUMP TYPE (Circle One):
 Submersible, Turbine, Jet Flowing Well,
 Other (Describe) _____
 POWER TYPE (Circle One):
 Electric, Tractor, Diesel, Gasoline, Butane,
 Other (Describe) _____ H/P 1
 Pump Capacity (GPM) 6 No. of Stages 2 Setting Depth _____ FT.
PUMP TEST
 Well yielded _____ GPM with
 a drawdown of _____ ft.
 after _____ hours of pumping

WELL DATA
 Well Depth 320 Casing Diameter (In.) 2" Casing Length (Ft.) 310'
325'
 Type of Casing PVC Hole Depth 325' Depth to Static Water Level 80'
 TYPE OF COMPLETION: (Circle One or More):
 Gravel Packed, Underreamed, Telescoped,
 Natural Development, Open Hole, Other
 (Describe) _____
WELL GROUTED TO A DEPTH OF 20 FEET
 Type Grout (circle one): Cement, Bentonite, or Mix

LOG DATA
 TYPE OF LOG RUN (Circle One): No Log Run,
 Electric, Gamma-Ray, Density, Sonic, Neutron,
 Other (Describe) _____
 Name of Organization Running Log _____

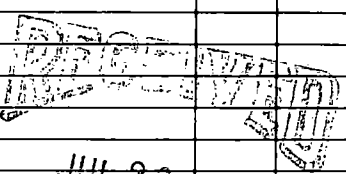
SCREEN DATA
 Diameter - Inches 2" Length - Feet 10' Slot Size - Inches .004
 Screen Type PVC Depth to Bottom - Feet 320'

GEOLOGIC DATA (Office Use Only)

Surface Elev.	Geologic Unit	Unit Thickness	Depth to Top
Subs. SWL	Date	Analysis	Aquifer Test

Driller's Remarks

DESCRIPTION OF FORMATIONS ENCOUNTERED	FROM	TO	FORMATIONS (Continued)	FROM	TO
<u>top soil</u>	<u>0</u>	<u>2</u>			
<u>yellow clay</u>	<u>2</u>	<u>15</u>			
<u>med. to coarse sand</u>	<u>15</u>	<u>84</u>			
<u>blue clay soft sand</u>	<u>84</u>	<u>290</u>			
<u>med. sand</u>	<u>290</u>	<u>320</u>			
<u>blue clay</u>	<u>320</u>	<u>325</u>			

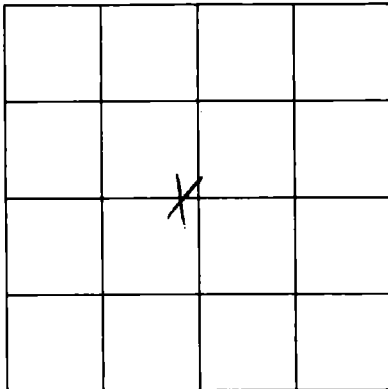

JUL 26 1993
 Dept. of Environmental Quality
 Office of Land & Water Resources

IF MORE SPACE IS NEEDED, USE BACK

4

If well telescopes please sketch and show depths.

GROUND LEVEL



SECTION 26

Please indicate well location X.

ADDITIONAL INFORMATION

If more than one screen, show location of each on sketch.